


P-39635
56877

T.14S., R.31E., W.M.

SECTION II

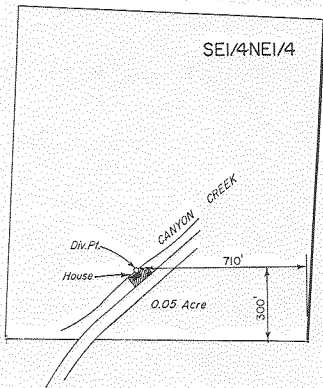

SCALE 1" = 400'

FINAL PROOF SURVEY UNDER

Application No. 52509 Permit No. 39635
IN NAME OF

Alice Thomas & Estate of Jack B. Thomas

Surveyed SEPT 30 1981, by DL