


T. 10S., R. 40E., W. M.

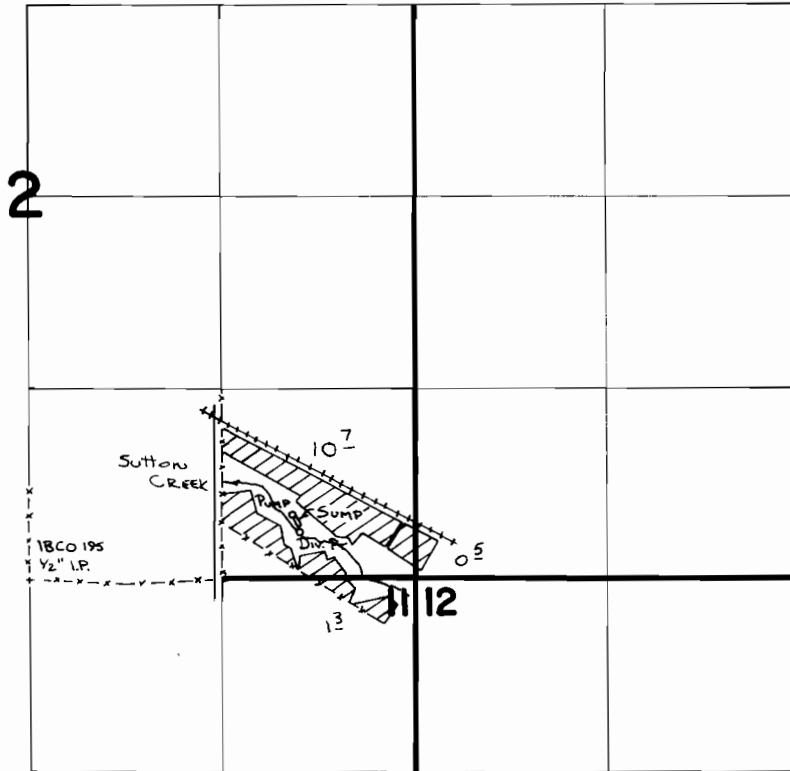

Div. Pt. Loc: 320' N. & 790' W. FROM SE COR. SEC 2

SUMP Loc: 400' N. & 810' W. FROM SE COR. SEC 2

**FINAL PROOF SURVEY**  
UNDER

Application No. **52516** Permit No. **39638**  
**G-8727** **G-8095**  
IN NAME OF

**JAMES A. ATTAWAY**

Surveyed 6-4 1986, by V. b. Church