


# T. 39 S., R. 8 W., W.M.

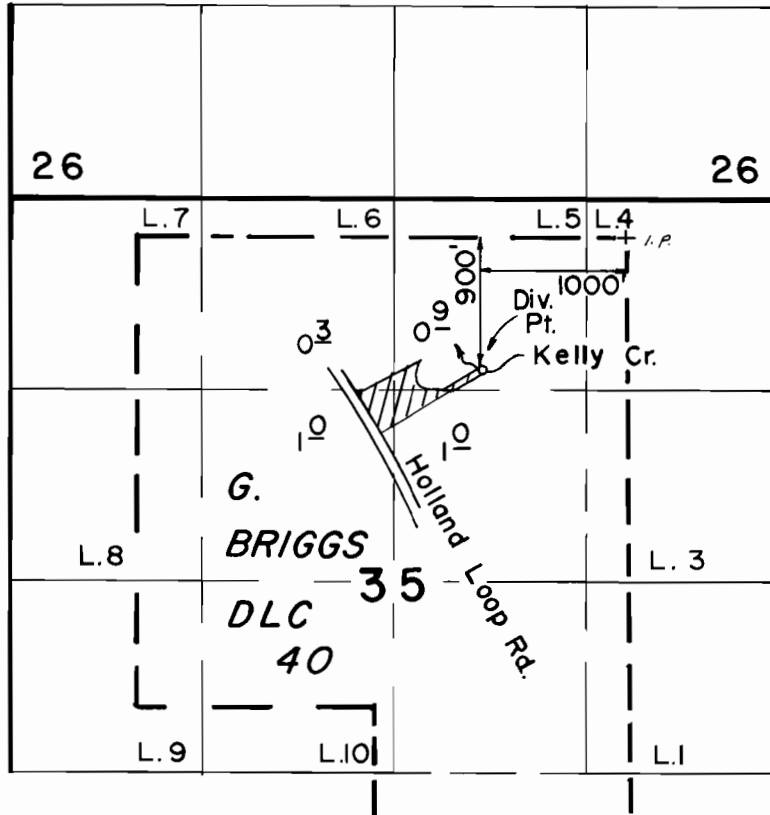

Scale: 1" = 1320'

## FINAL PROOF SURVEY UNDER

Application No. ~~52652~~ 52652 Permit No. 39678..

IN NAME OF

BARBARA PRATT

Surveyed MAY 13 1986, by B.S. JAMES..