

T. 13 S. R. 6 W. W. M.


SECTION 1

C-1/4

NE 1/4 SW 1/4

WITHIN ANDREW FOSTER

D. L. C. 37

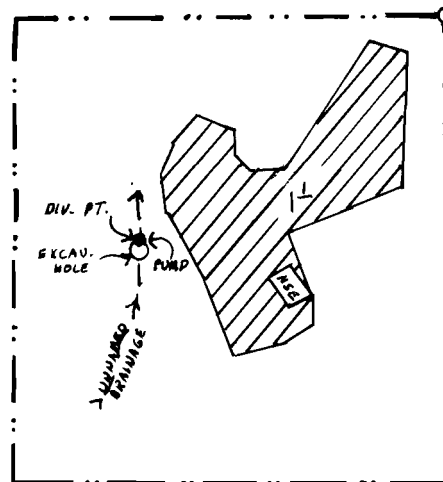

DIV. PT. LOC.: 800' W. & 780' S.
From the C-1/4 Section 1.

SCALE: 1" = 200'

FINAL PROOF SURVEY
UNDER

Application No. 53422. Permit No. 39.7.5.3.....

IN NAME OF

JAMES COCHELL

Surveyed JUNE 23, 1983, by L. T. O. L. L.

PTS - 19832

TMW