


T.13S., R.9E., W.M.

SECTION 10

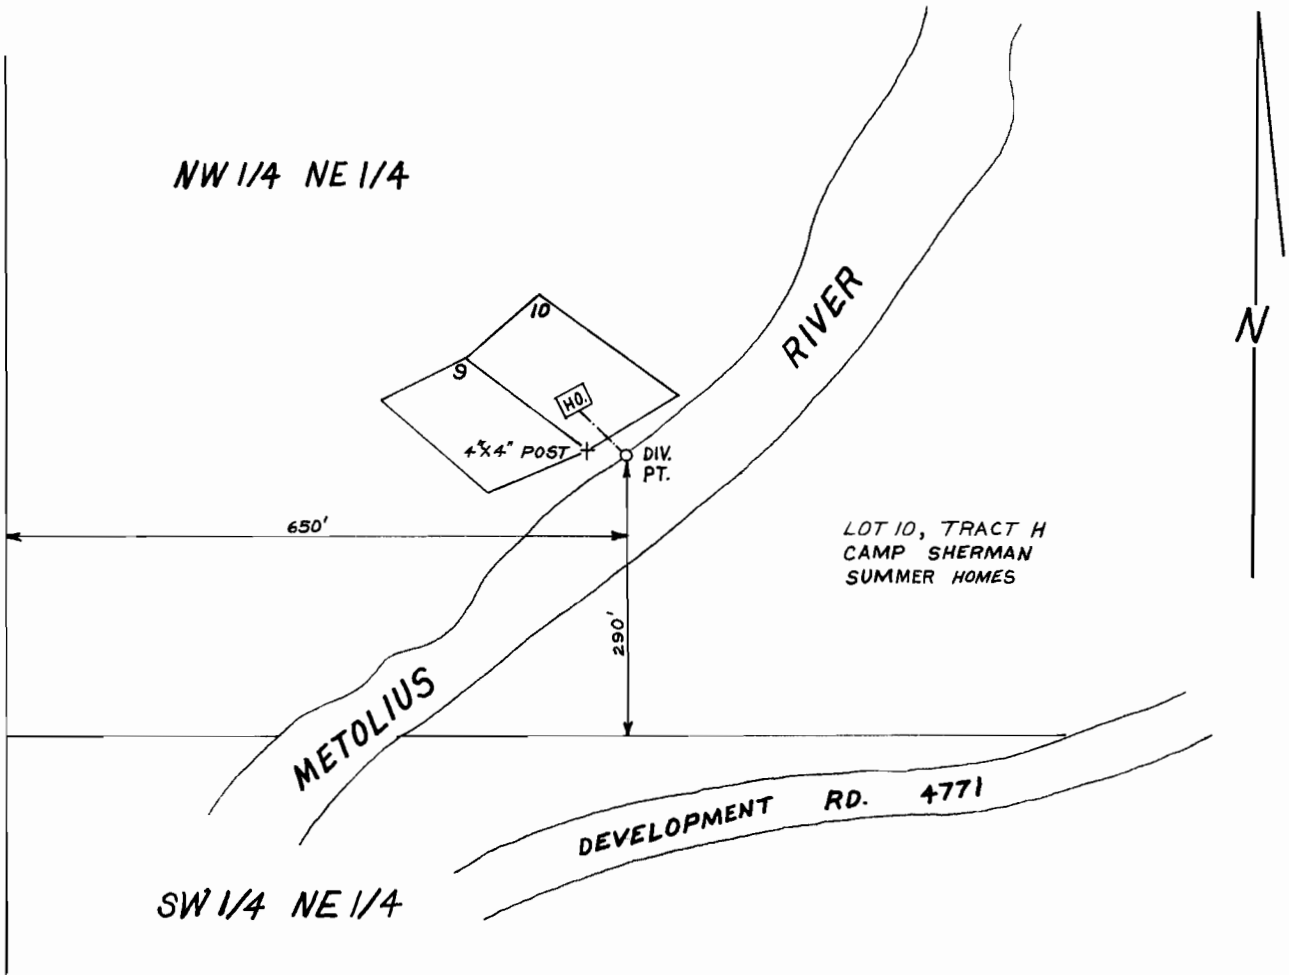

SCALE: 1" = 200'

FINAL PROOF SURVEY

UNDER

Application No. 65487 Permit No. 47966

IN NAME OF

CHARLES O. BENNETT, JR.

Surveyed FEB. 28 19 85, by LESLIE OLSON