


T.13S.,R.1W.,W.M.

Section 2

SW 1/4 NW 1/4

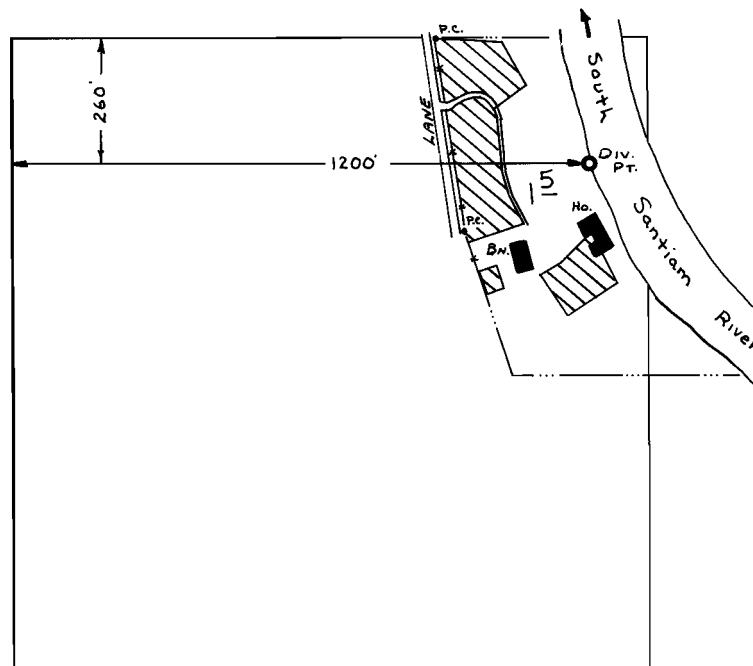

SCALE: 1" = 400'

FINAL PROOF SURVEY
UNDER

Application No. .53461... Permit No. ...39774....
IN NAME OF

WILLIAM H. & BARBARA J. BROOKS

Surveyed April 26, 1982, by L.M. JOLL