
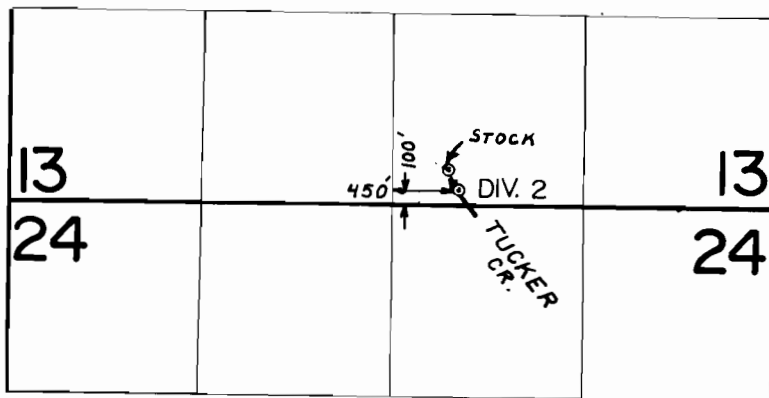


T.28S., R.5W., W.M.

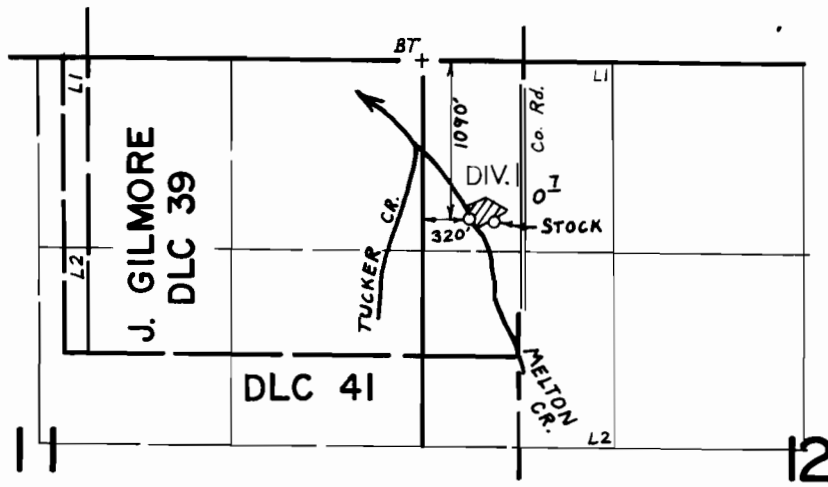

SCALE: 4" = 1 mile

FINAL PROOF SURVEY
UNDER

Application No. 52766.. Permit No. 39840.....
IN NAME OF

BENJAMIN B. MELTON

Surveyed JUL 9 1984, by *L. Cochran*.....