


# T.26S.,R.6W.,W.M.

## Section 14

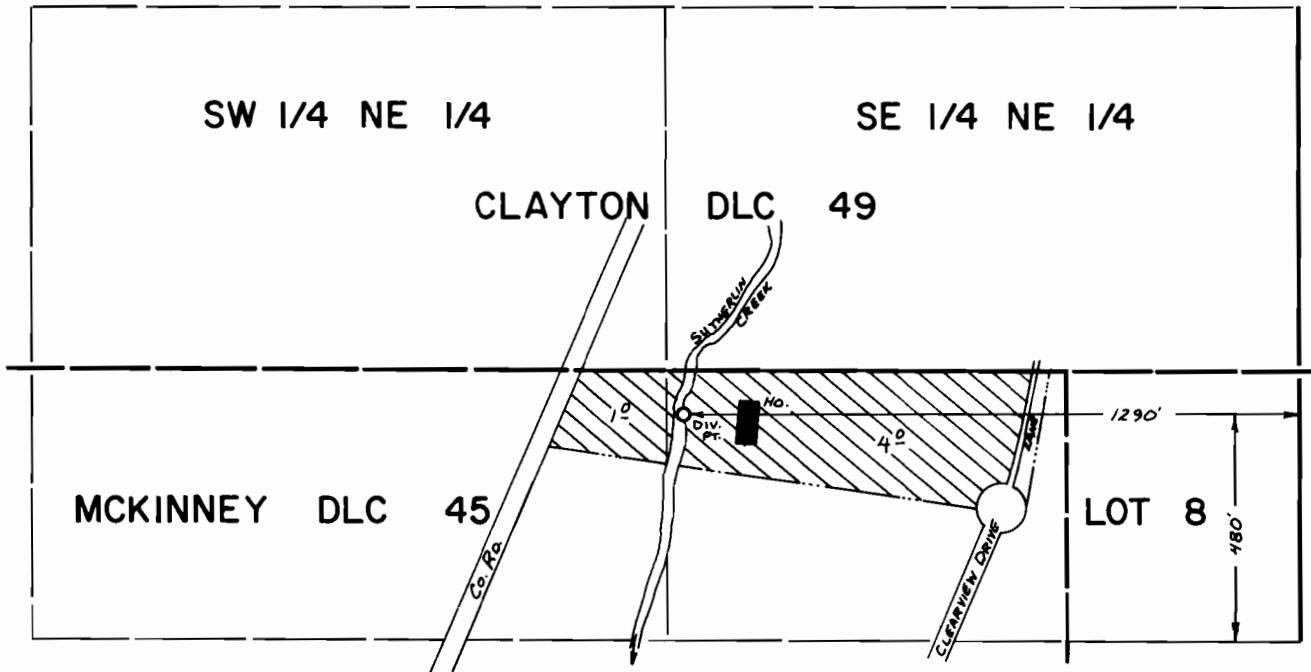

SCALE: 1" = 400'

### FINAL PROOF SURVEY UNDER

Application No. .52813... Permit No. ...39861.....

IN NAME OF

.....LARRY D. DURST.....

Surveyed .May...13... 19.82., by .L.M.TOLL.....