


T.IOS.,R.IE.,W.M.

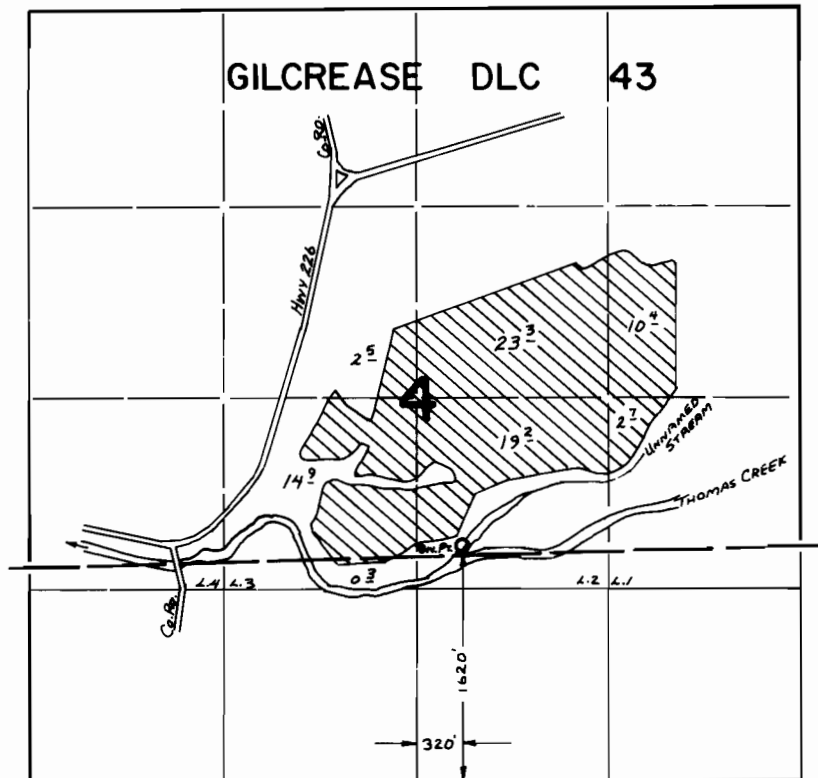

FINAL PROOF SURVEY UNDER

Application No. 52887... Permit No. 39914.....
IN NAME OF

.....CARL & JOHN HENDRICKS.....

Surveyed June 9, 1982, by L.M. TOLL.....