


T. 16 S., R. 2 E., W. M.

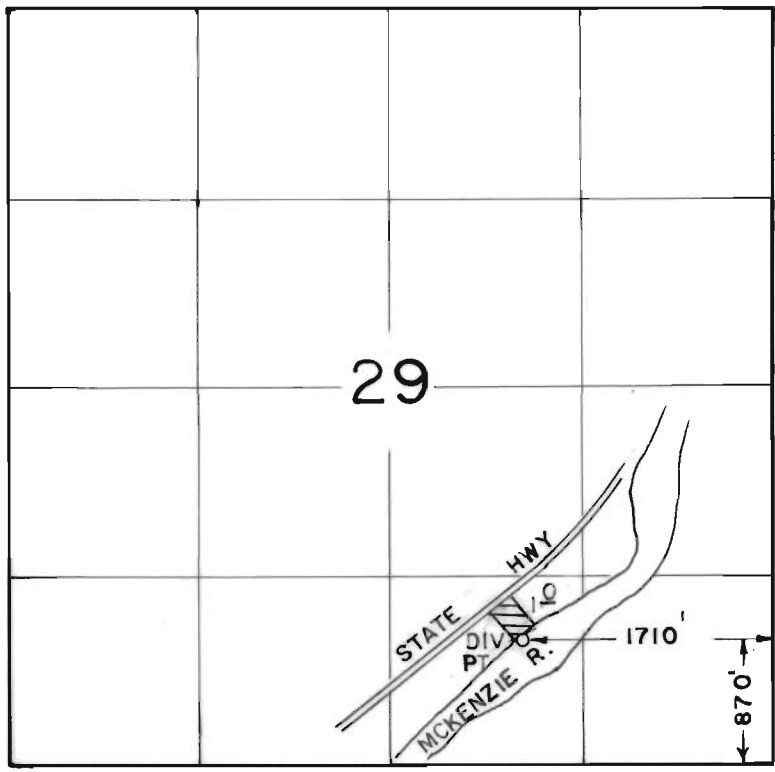

SCALE
1" = 1320'

FINAL PROOF SURVEY
UNDER

Application No. 50874. Permit No. 39943.....
IN NAME OF

JOSEPH DE PALMA & ROBERT ZEISS

Surveyed JUN 25 1984, by P. PAGTER.....