


T.5S., R.9W., W. M.

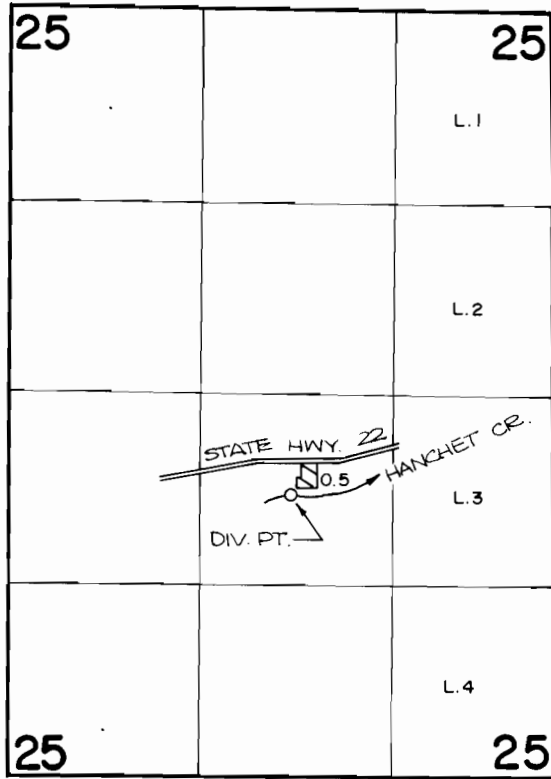

DIV. PT. LOCATION: 3300 FT. S. AND 1760 FT. W. FROM THE N.E. CORNER OF SECTION 25.



SCALE: 4" = 1 MILE

FINAL PROOF SURVEY UNDER

Application No. 52939 Permit No. 39968
IN NAME OF

ADAM & DOLLY REZNICSEK

Surveyed NOV. 16, 1984, by P. Pagter