


T.25 S., R.7 W., W.M.

SECTION 27

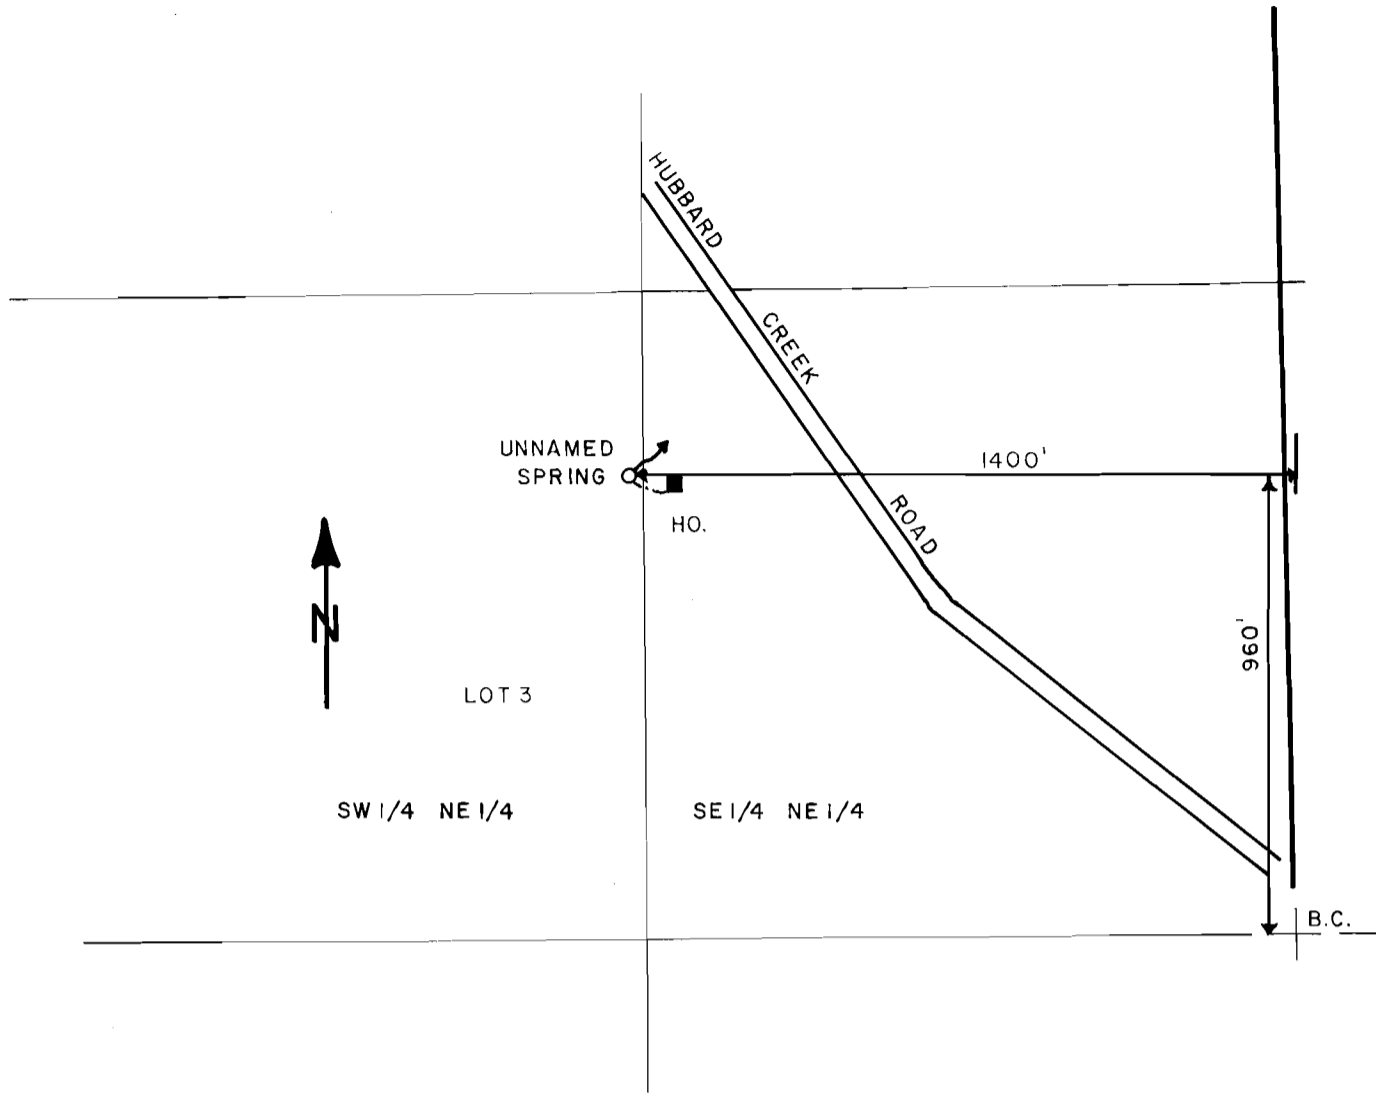

SCALE: 1" = 400

FINAL PROOF SURVEY UNDER

Application No. 65569 Permit No. 47993
IN NAME OF

CLAUDE ERNEST CRANE & GWENDOLYN H. CRANE

Surveyed AUG. 6 1986, by J.M. SCHMORDE