


T. 34 S., R. 6 W., W.M.

Sec. 13

NE 1/4 SE 1/4

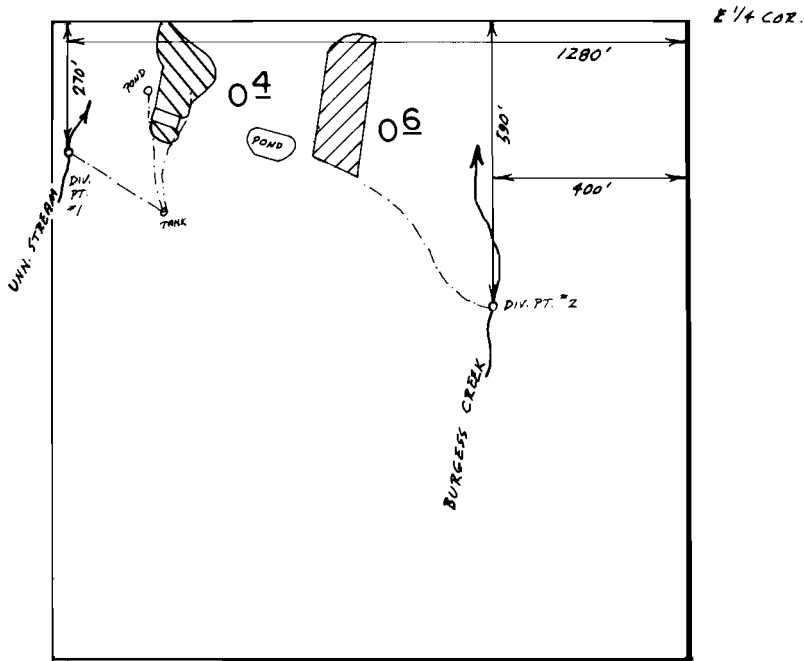

Scale 1" = 400'

FINAL PROOF SURVEY
UNDER

Application No. 52969 Permit No. 39987
IN NAME OF

DARIO A. SCARABOSIO

Surveyed Sept. 18, 1984, by J.R. WOODROOF