


T.21S. R.3W. W.M.

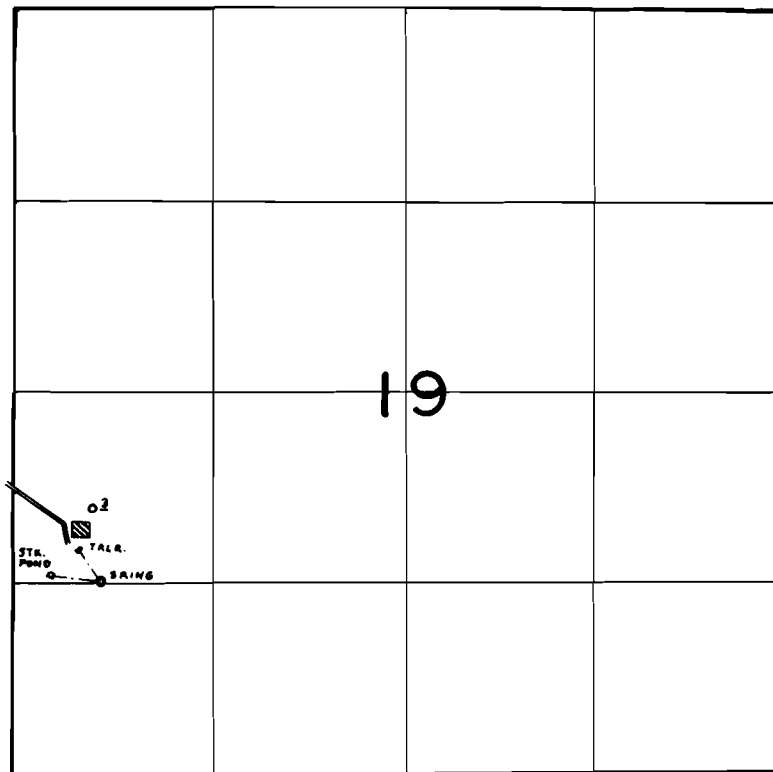

SPRING LOC : 1340' N. & 610' E. fr. S.W. COR. SEC. 19.

FINAL PROOF SURVEY
UNDER

Application No. 56412... Permit No. 42499.....
IN NAME OF

.....GERALDINE INGERSOLL.....

Surveyed June..18.. 19.80, by ..C.L. Hughes.....