


TIOS. RIOW. WM.

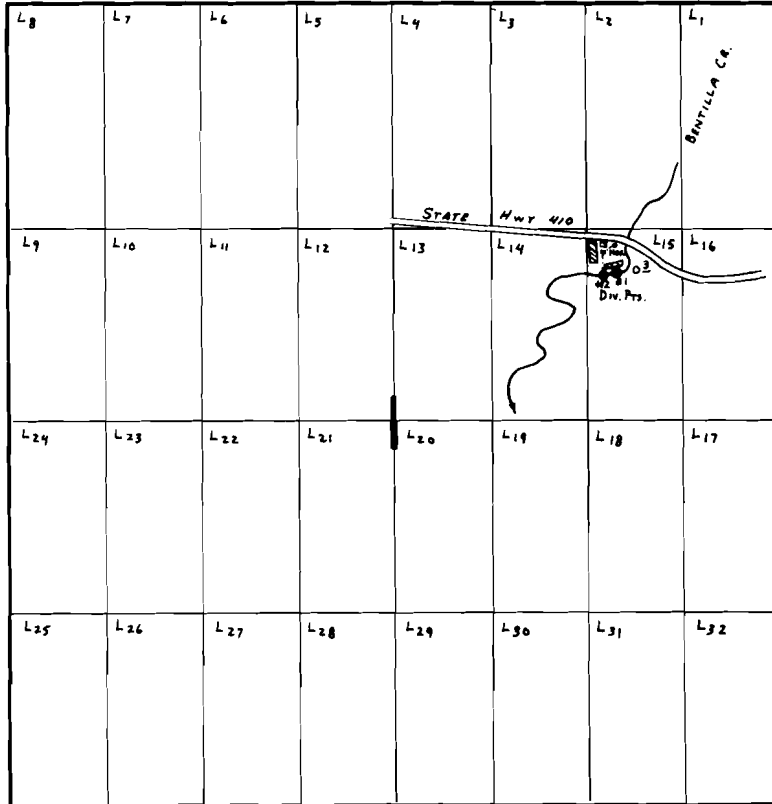

Div. Pts. Loc: #1- 1850' S. & 1100' W. }
 #2- 1870' S. & 1200' W. } BOTH FROM N.E. COR. SEC. 1.

FINAL PROOF SURVEY UNDER

Application No. 58354 Permit No. 43990.....
 IN NAME OF

ISABEL BENTLEY

Surveyed May 22, 1980, by C. L. Hughes.....