


T.16S., R. 7W., W.M.

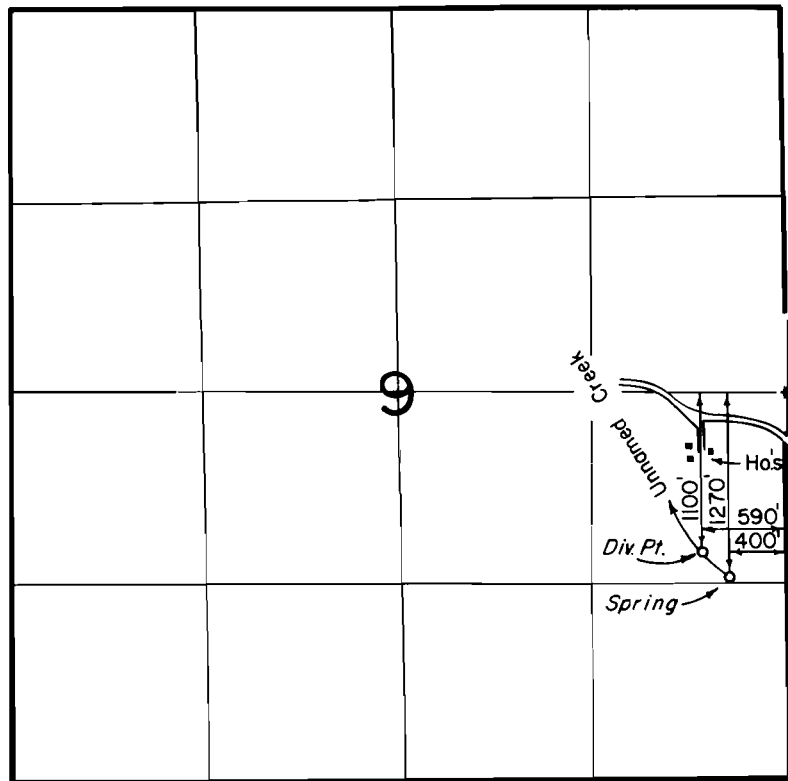

FINAL PROOF SURVEY
UNDER

Application No. 58619 Permit No. 44254

IN NAME OF

CHARLES F. HEDBLUM

Surveyed MAY 16, 1980, by [Signature]