


T. 2S., R. 39E., W. M.

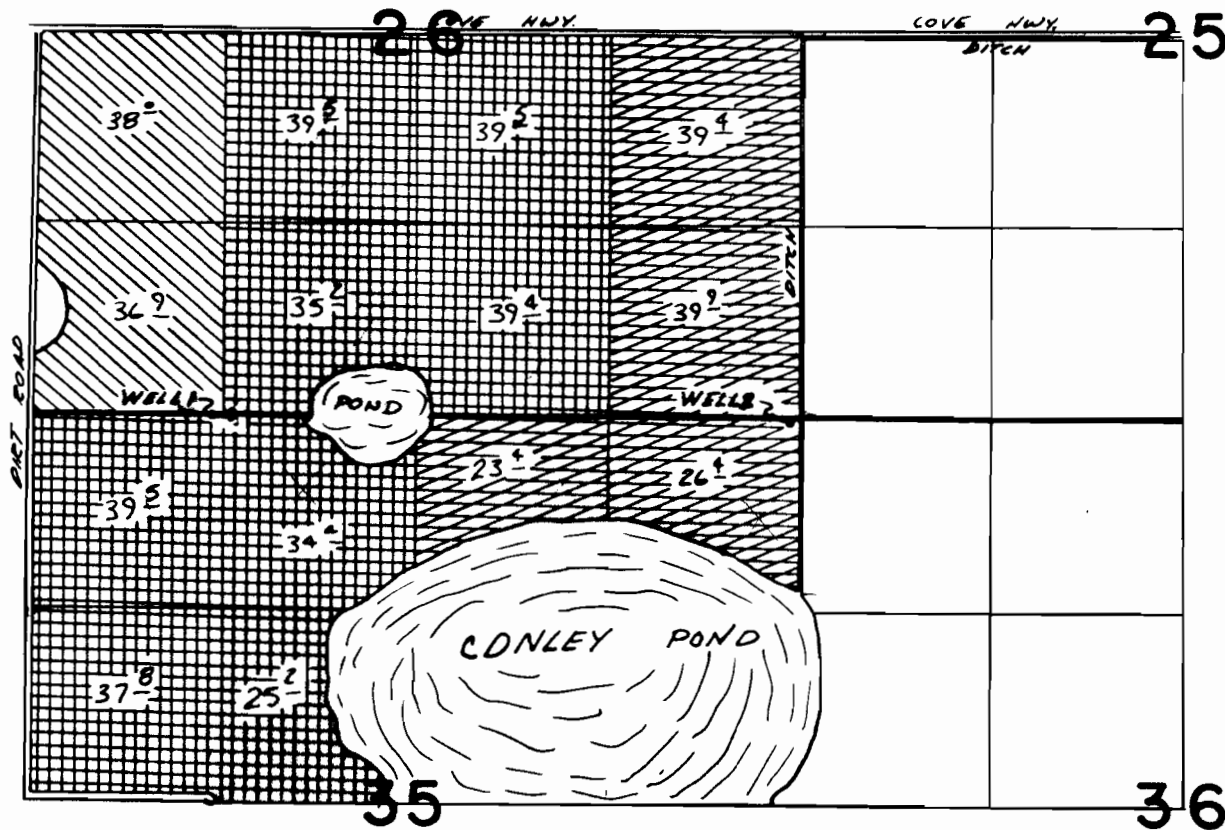

WELL 2 LOCATED 40' S. & 80' W. FROM NE COR SEC 35, T. 25. R. 39 E. W.M.

WELL 1 LOCATED 1360' E. FROM NW COR SEC 35 T. 25. R. 39E. W.M.

SUPP' 1-

SUPPL 1 -  PERMIT G-6492  PERMIT G-6659
SUPPL 2 -  PRIM PRIM  PERMIT G-5954
PRIM


FINAL PROOF SURVEY

UNDER

G-6986

G-6492

G-6354

G-5954

Application No. G-7261 Permit No. G-6659

IN NAME OF

The Federal Land Bank of Spokane

CARMARCO, INC.

Surveyed Aug. 28, 1979, by Harmon L. Church
Nov. 17 81