

Form A1-187
March 1961

UNITED STATES
DEPARTMENT OF THE INTERIOR
BUREAU OF LAND MANAGEMENT


SECTION

Oregon State Water Filings

26

TOWNSHIP 39-S, RANGE 26-E, W. M.

North

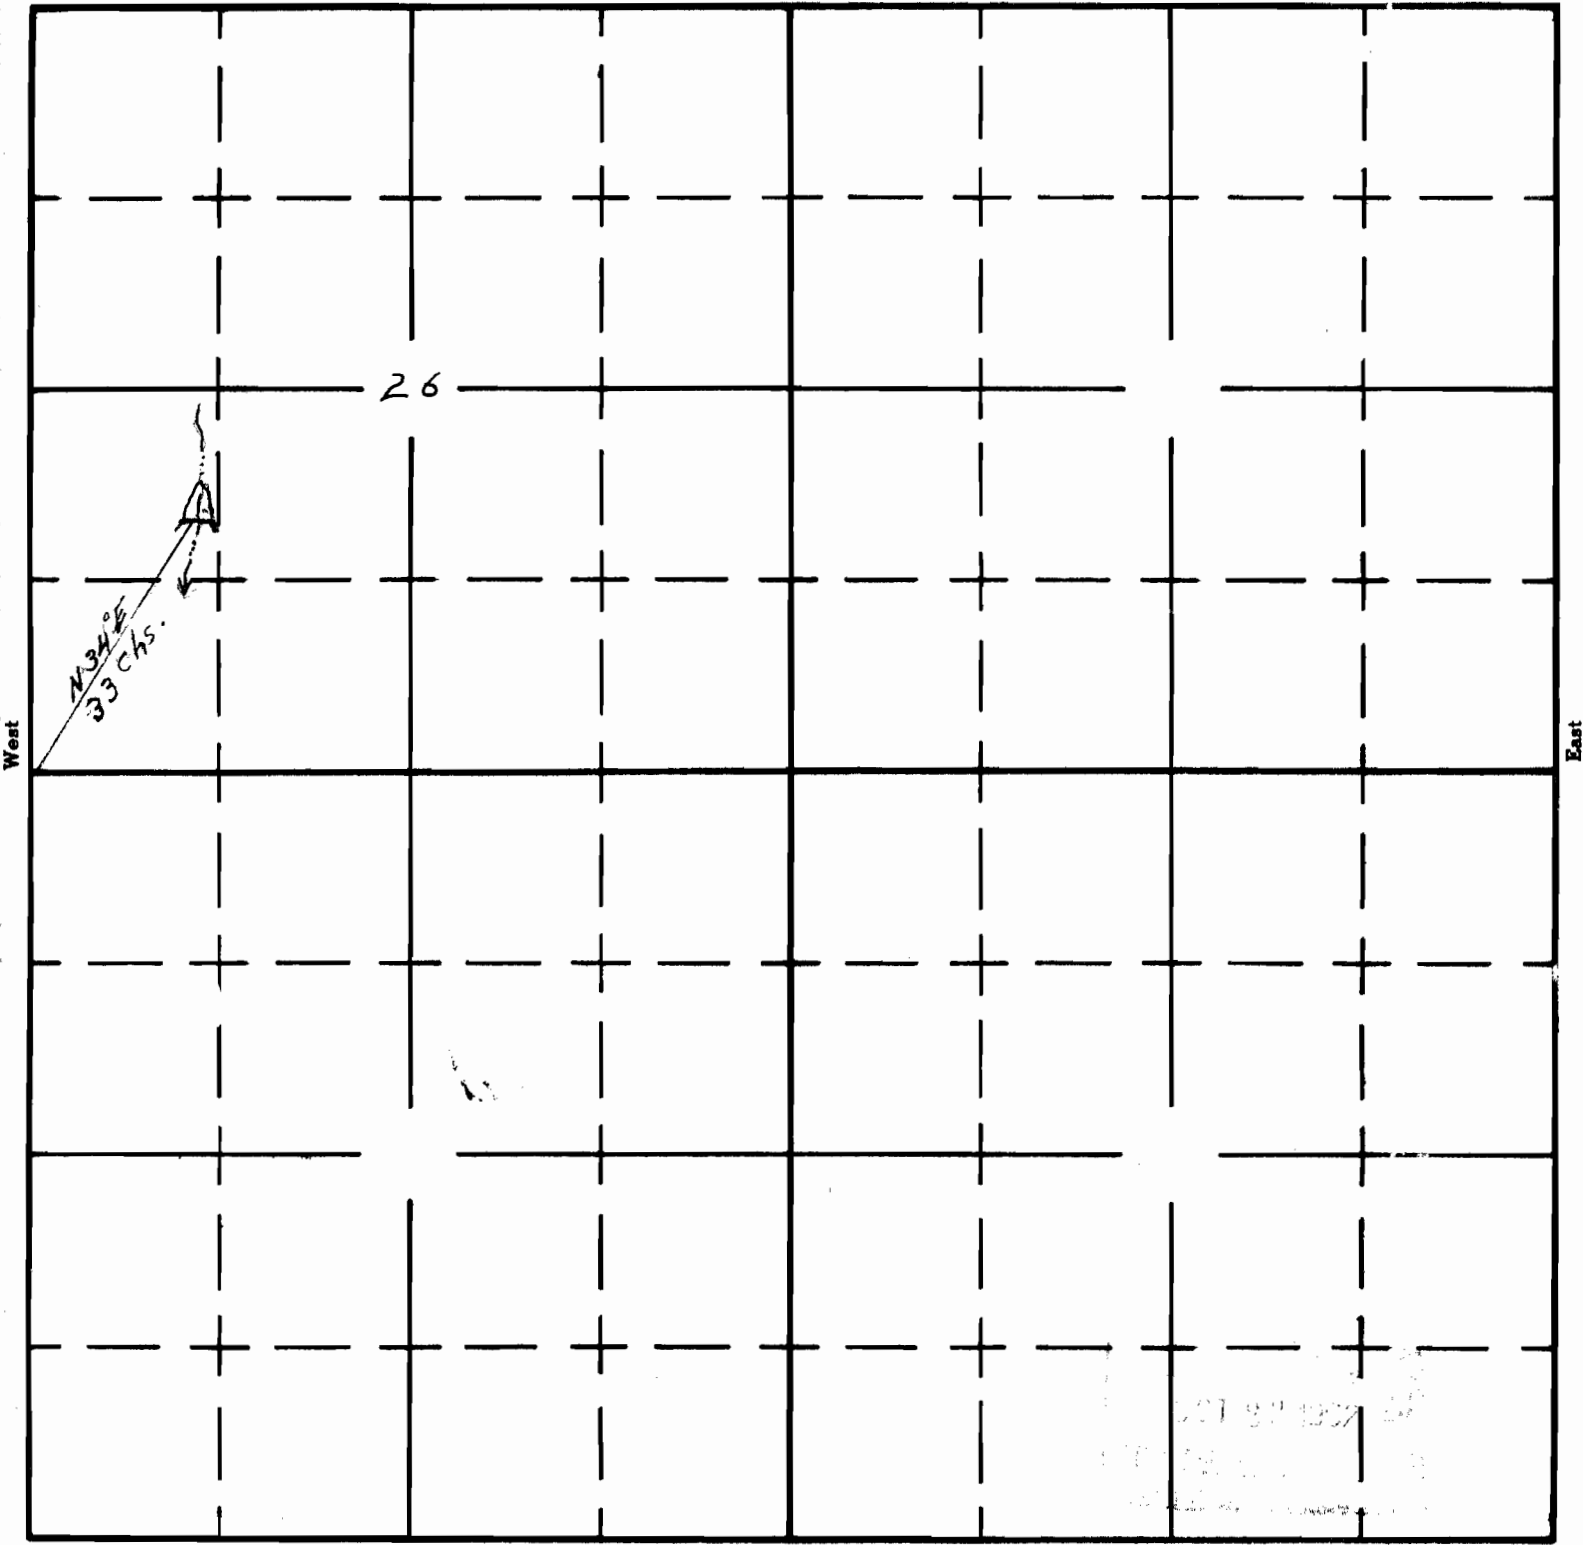

South

APPLICATION No. R-35166
PERMIT No. R-2965