


T.3N. R.10E. W.M

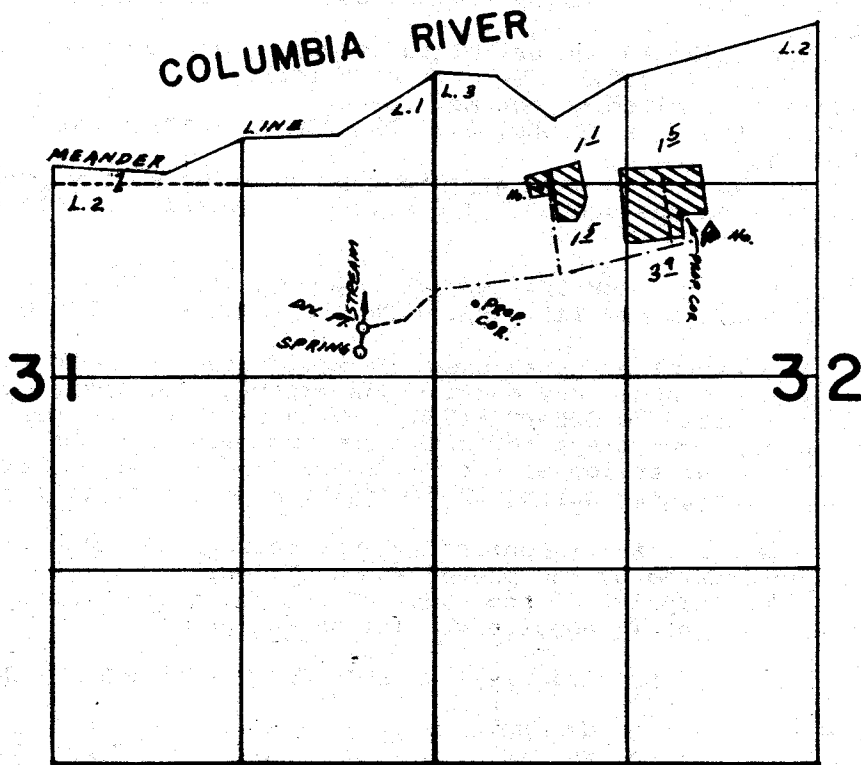

SPRING LOC. 170' N. & 510' W.; DIR. PT. LOC. 340' N. & 490' W.
FROM EAST 1/4 COR. SEC. 31.

FINAL PROOF SURVEY UNDER

Application No. 44709... Permit No. 33287...
IN NAME OF

RAYMOND M. & PATRICIA J. GALLIGAN

Surveyed OCT. 26 1977, by L.H. NUNN
APR. 16 1980 R. G. MUCKEN