


T.2S., R.12E., W.M.

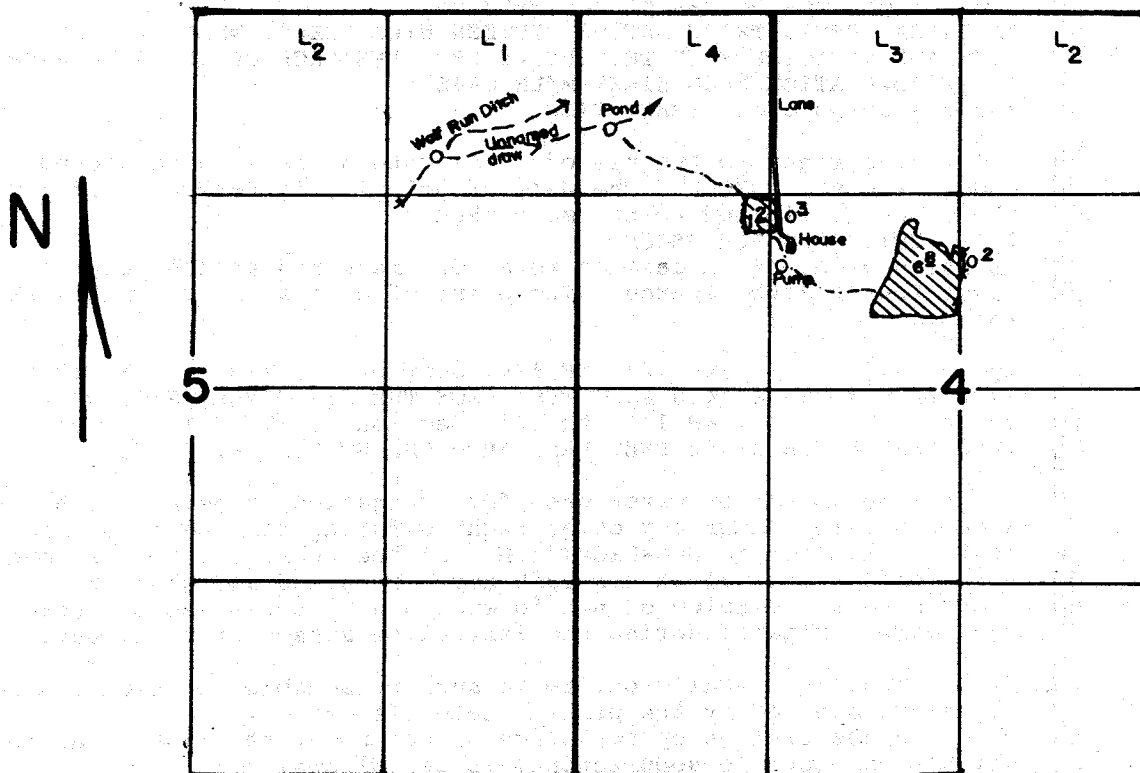

Tamarack Crk. Div. Point Located : 1200' N. & 1400' W. from the SE Cor. Sec. 6., T.2S., R.12E.

Eightmile Crk. Div. Point Located : 1400' N. & 650' E. from the SW Cor. Sec. 8., T.2S., R.12E.

Scale : 4" = 1 Mile

FINAL PROOF SURVEY UNDER

Application No. 50092.. Permit No. 37640.....
IN NAME OF

JAMES W. & JULIA DENNIS.....

Surveyed AUG. 19., 1983., by THOMAS. PAUL....

TMW
41065-179-229 L