


# T.I.S.R.8W.W.M.

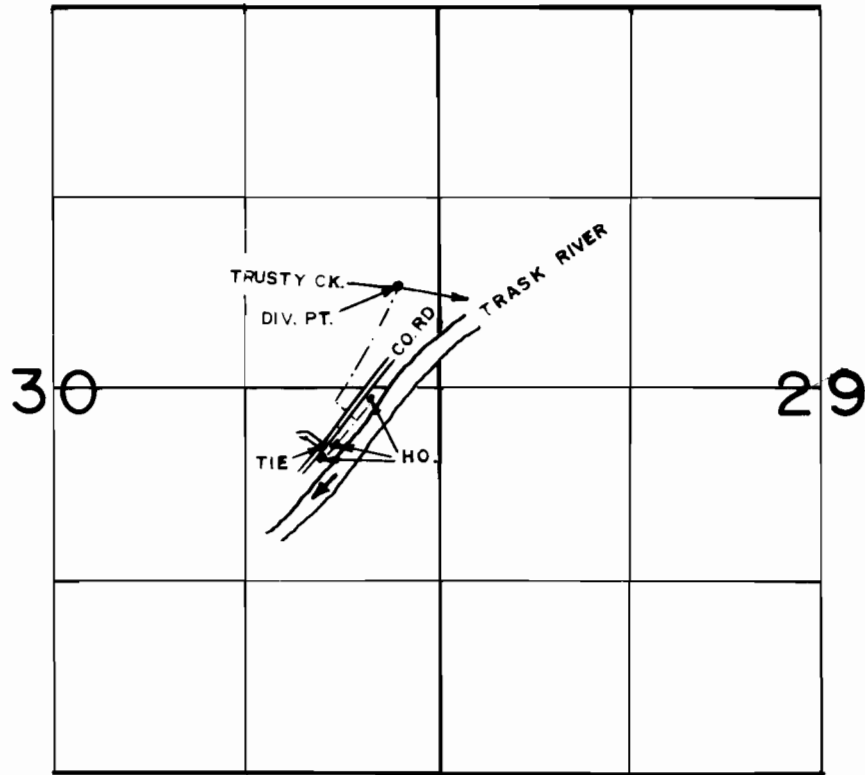

DIV. PT. LOC.: 700' N. & 260' W. FROM E. 1/4 COR. SEC. 30

## FINAL PROOF SURVEY UNDER

Application No. 52596.. Permit No. 39662.....  
IN NAME OF

..... JACK V. TRUSTY .....

Surveyed FEB 13, 1980, by R.G. MUCKEN.....