


T. 23S., R. 7 W., W.M.

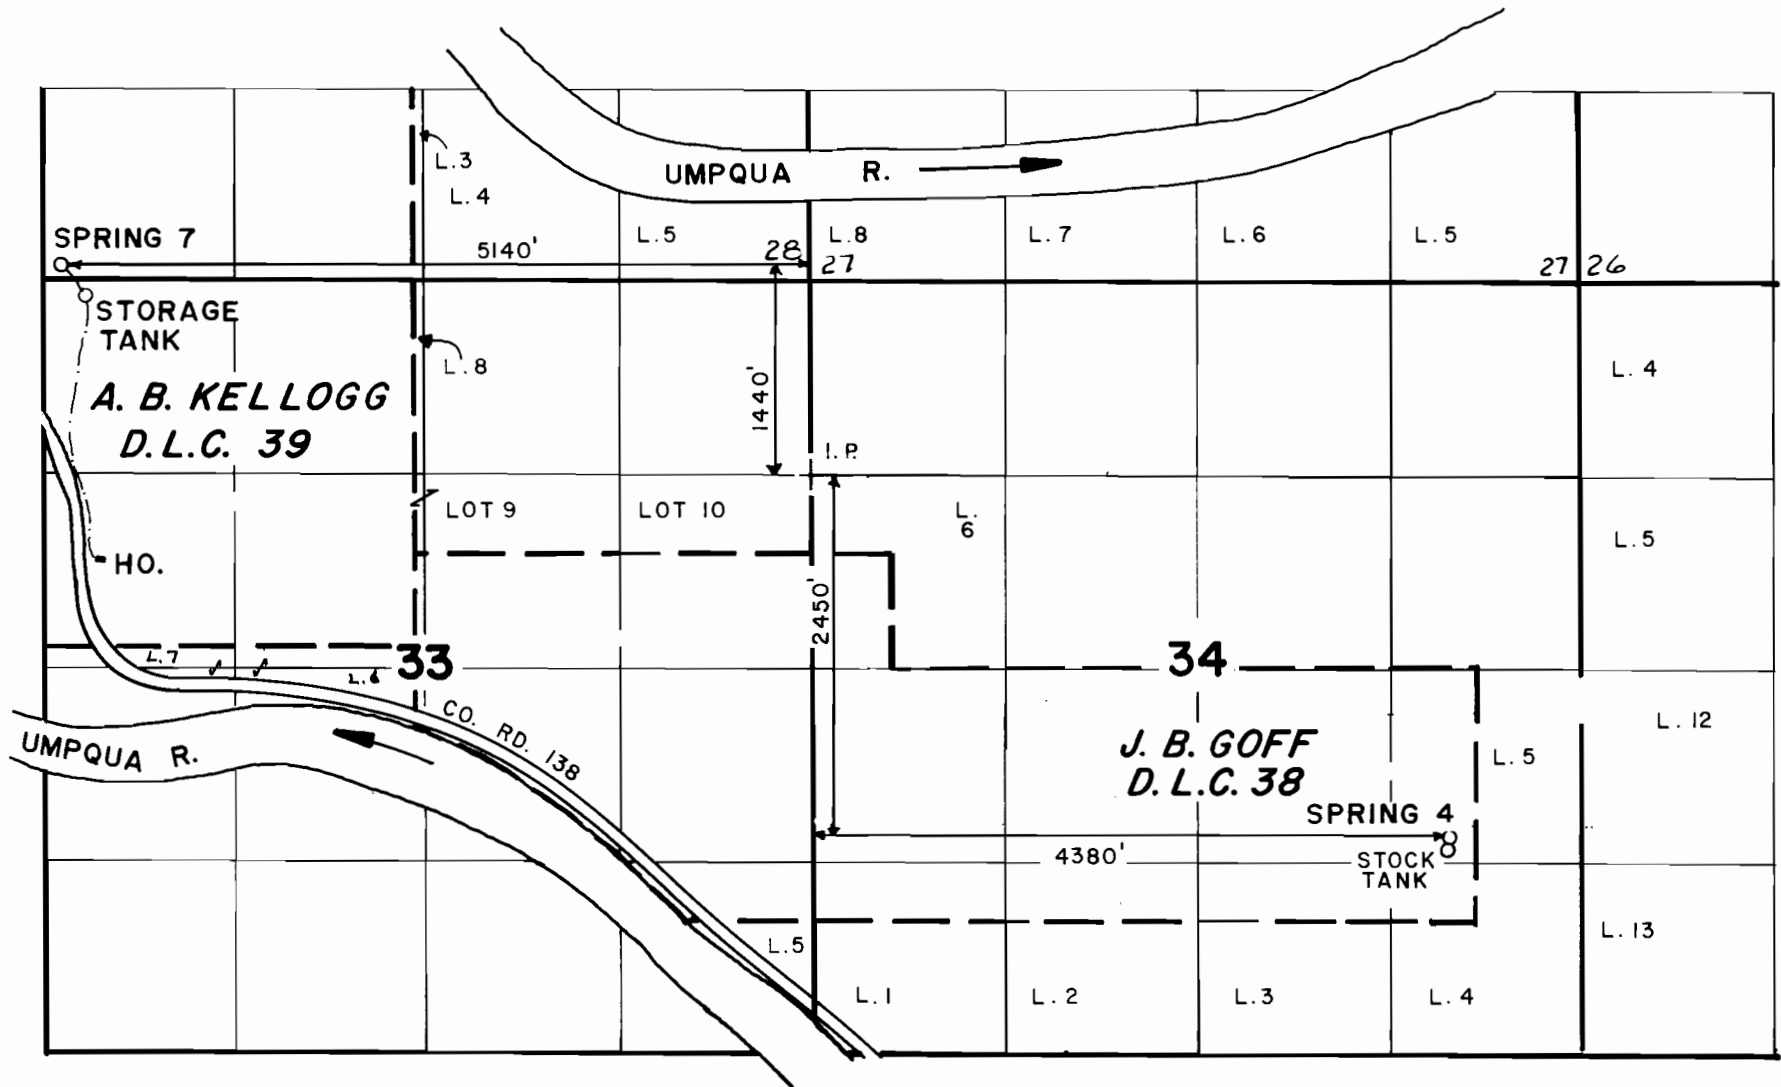

FINAL PROOF SURVEY

UNDER

Application No. 53695 Permit No. 40339.....

IN NAME OF

**DARRYL C. & KATHERINE L. RAY AND
INTERNATIONAL PAPER COMPANY**

SCALE: 4" = 1 MILE

Surveyed AUG. 27, 1986, by J. R. KAUPPILA

BTR-2HH-285

JK