


T. 37S., R. 8W., W.M.

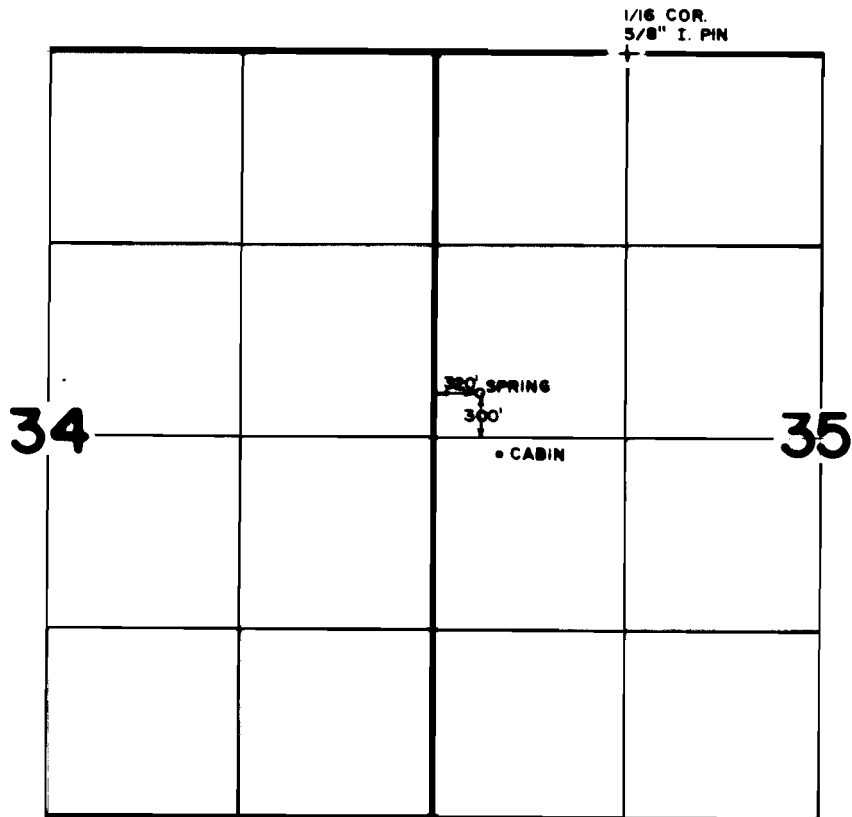

FINAL PROOF SURVEY
UNDER

Application No. **54307** Permit No. **40774**
IN NAME OF

J. THOMAS & BARBARA C. STROUT

Surveyed **OCT. 26, 1983**, by **B. S. JAMES**

SCALE: 4" = 1 MILE