

Cert: 56919

SE 1/4 SEC. 20 T. 17 S. R. 12 E. W.M.


Grid number 201

DESCHUTES COUNTY

SCALE: 1" = 400'

See Map 17 12 20A

17 12 20A

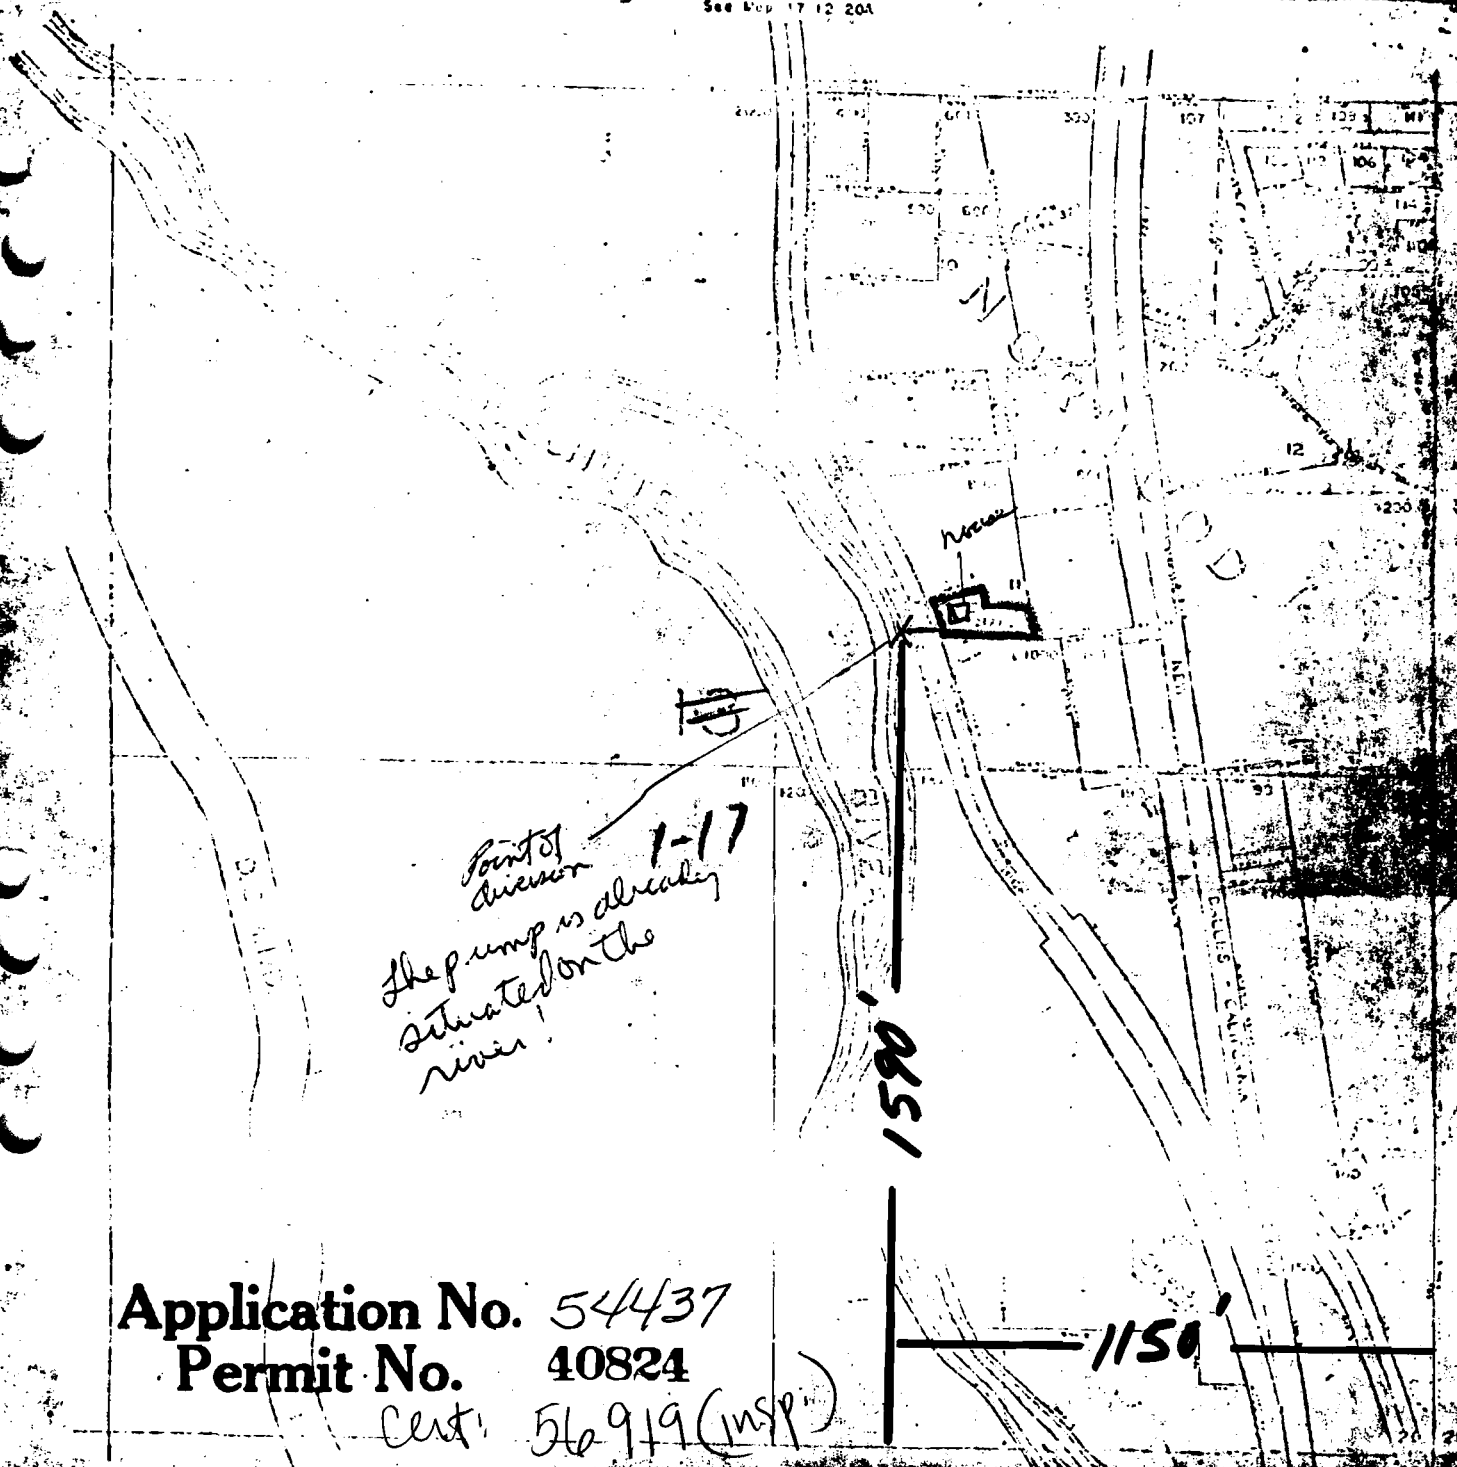

Point of diversion
 The pump is already
 situated on the
 river!

Application No. 54437

Permit No. 40824

Cert: 56919 (insp)

RECEIVED

SEP 13 1976

WATER RESOURCES DEPT
 SALEM, OREGON

40824