


T.15S.,R.6W.,W.M.

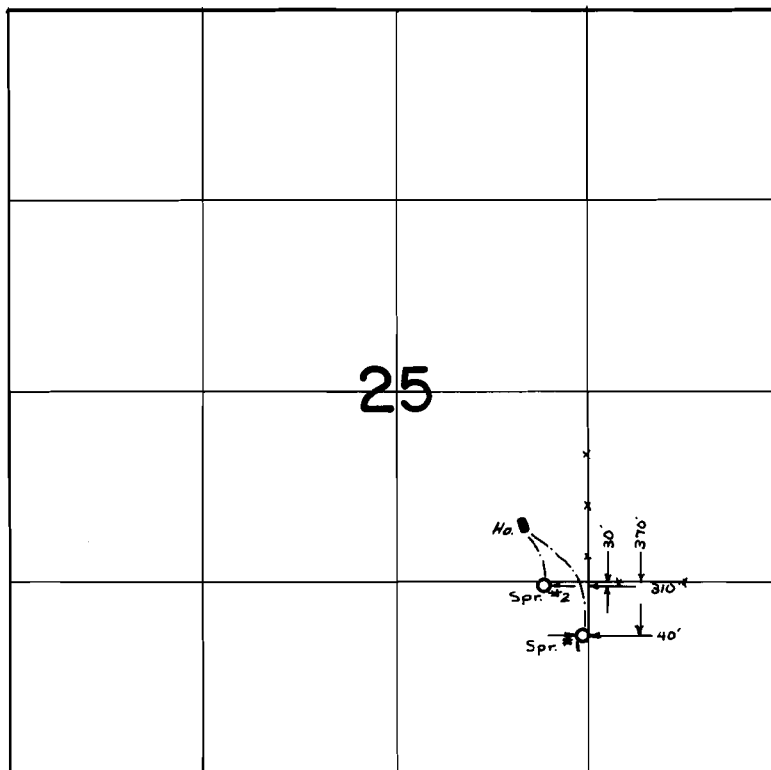

FINAL PROOF SURVEY
UNDER

Application No. 56568 Permit No. 42002

IN NAME OF

ELMO C. & JULIE C. SMITH

Surveyed June 17, 1982, by L. M. TOLL