



T. 33 S., R. 2 E., W. M.

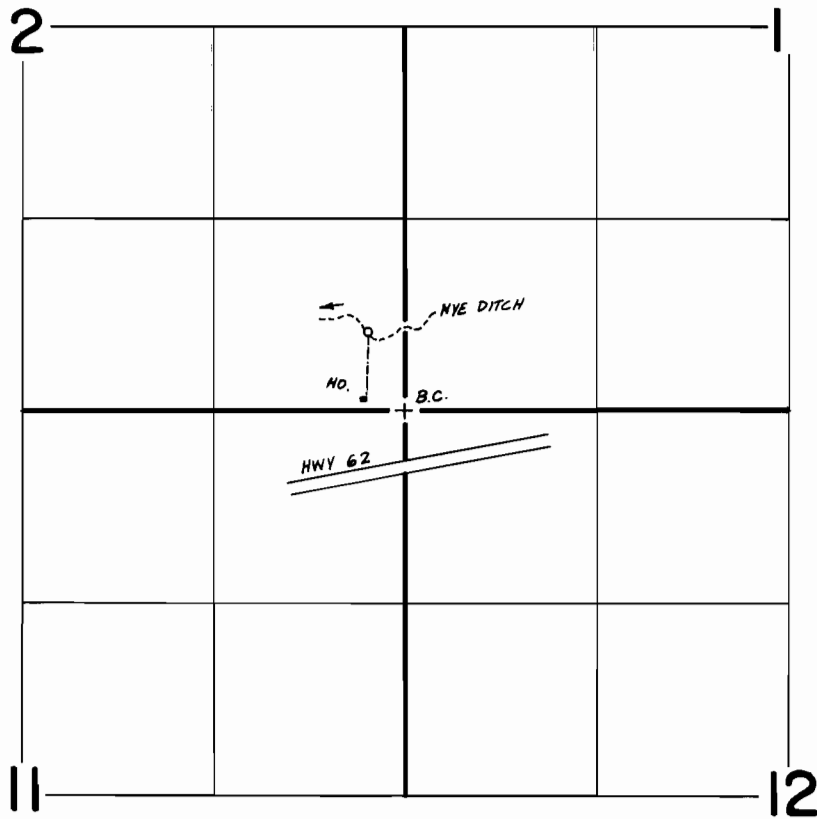

T. 32 S., R. 3 E., W. M.

SCALE 1" = 1320'

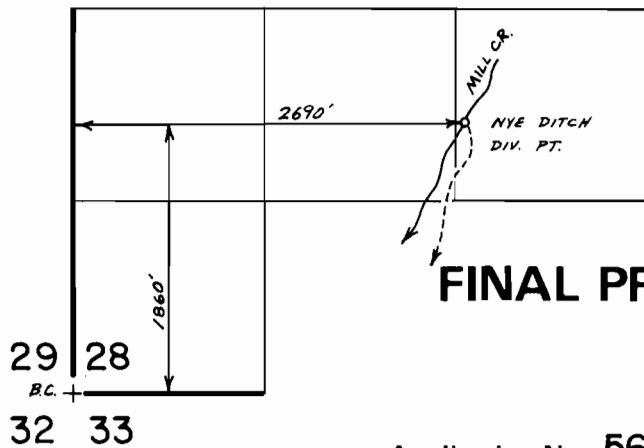

FINAL PROOF SURVEY UNDER

Application No. 56003 Permit No. 42048...
IN NAME OF

..LLOYD...&...or...LILLIAN...C...WANN

Surveyed May 23, 1983, by B.S. James.....