


T.37S., R.6W., W.M.

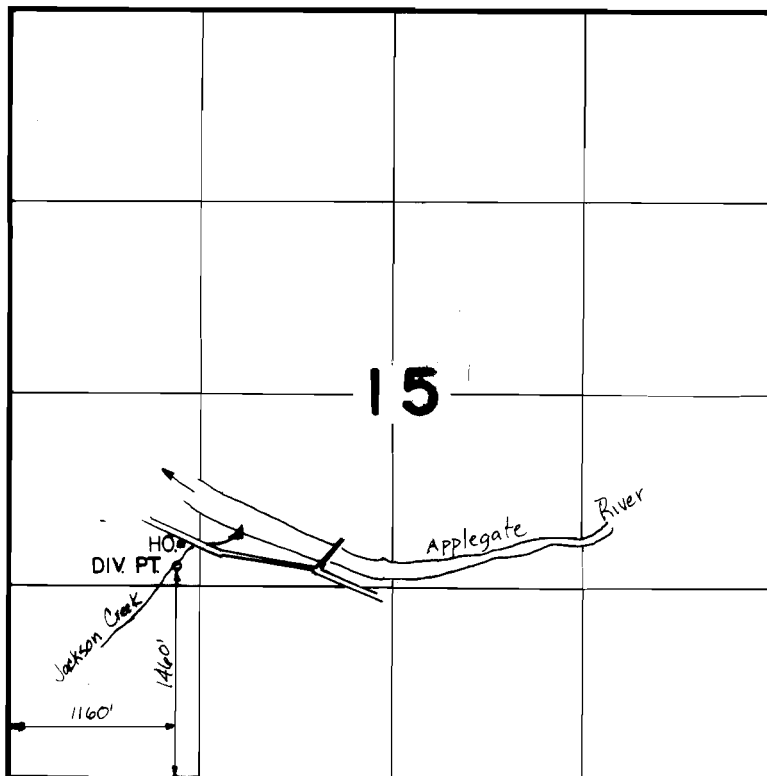

**FINAL PROOF SURVEY**  
UNDER

Application No. ....55940 Permit No. 42052.....

IN NAME OF

**HOMER C. RAND**

Surveyed ..OCT. 24, 1983., by ..B.S. JAMES.....