


T. 40 S., R. 8 W., W. M.

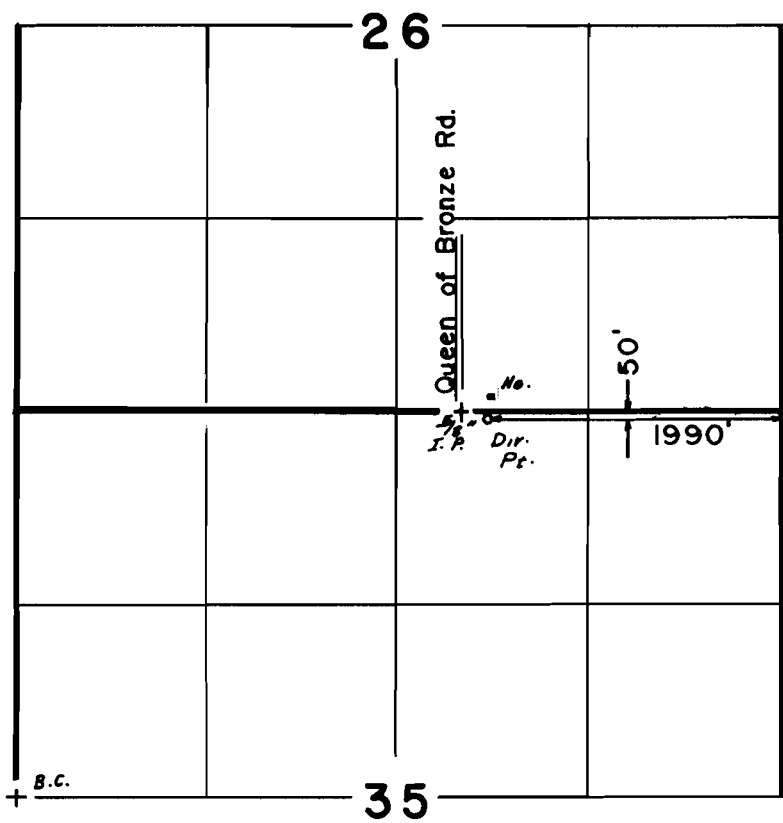

Scale: 1" = 1320'

FINAL PROOF SURVEY
UNDER

Application No. 55923 Permit No. 42053
IN NAME OF

KERRY WHITEHEAD

Surveyed APR. 18 1986, by B. S. JAMES