


T.4S.,R.1E.,W.M.

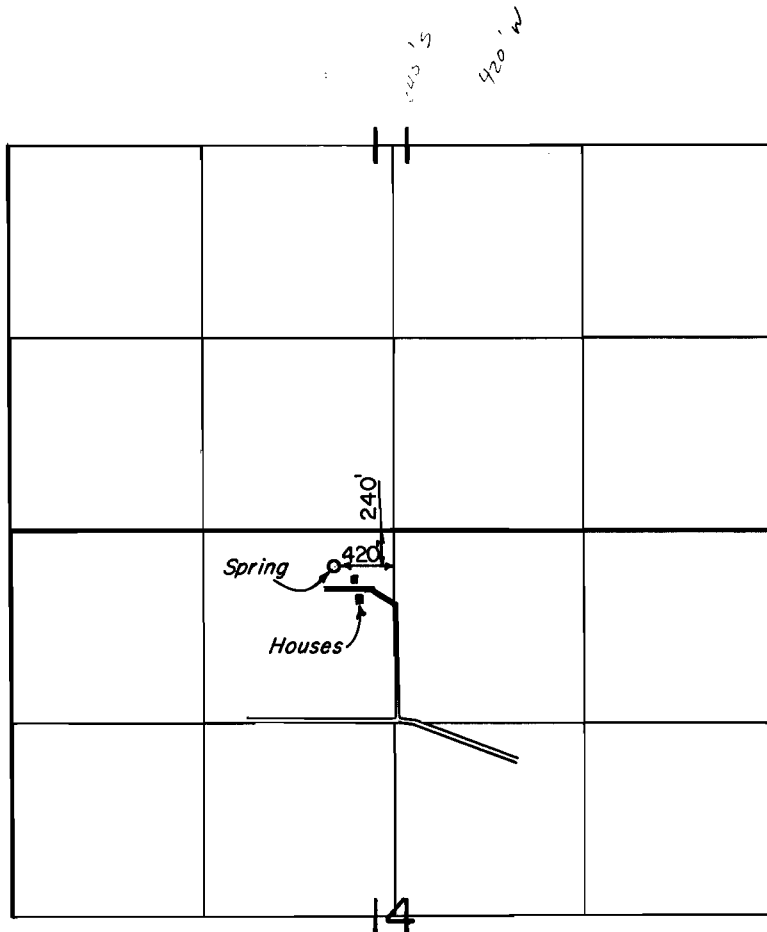

FINAL PROOF SURVEY UNDER

Application No. 56108 Permit No. 42113

IN NAME OF

DAVID W. KOENIG

Surveyed AUG. 14, 1981, by [Signature]