42730

56928

T. 41S. R. 9 & 10E. W.M.

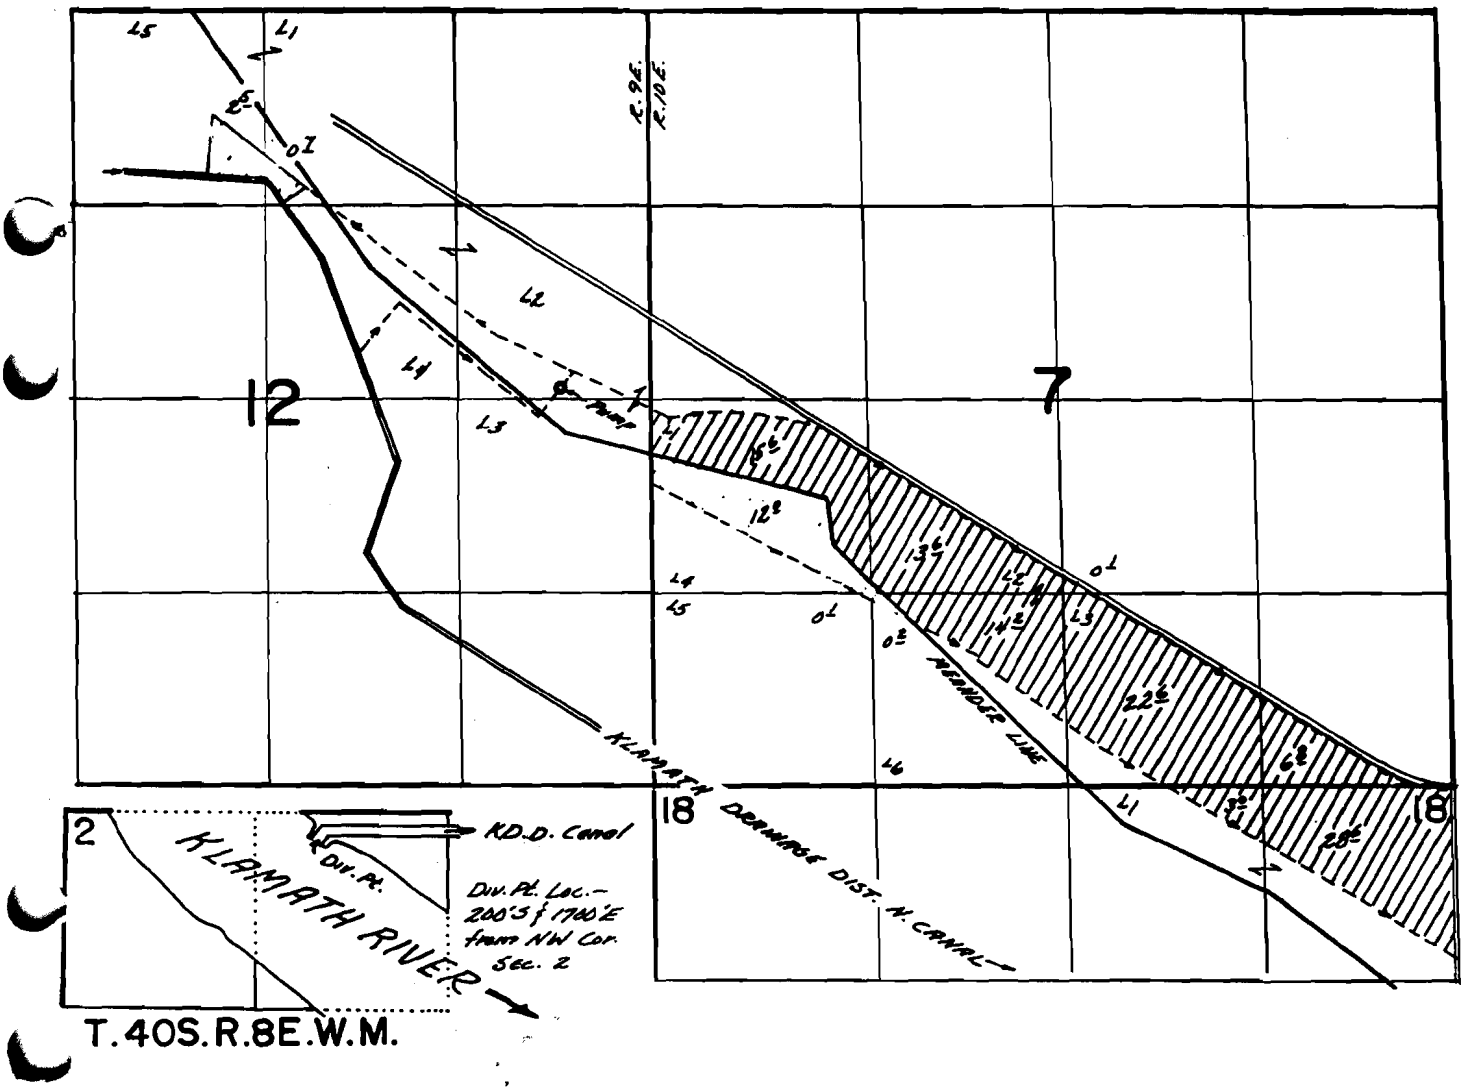

FINAL PROOF SURVEY
UNDER

Application No. 56705 Permit No. 42730
IN NAME OF

MUREL & BARBARA LONG

Surveyed Sept. 25 1979, by C.R. RODRIGUEZ