


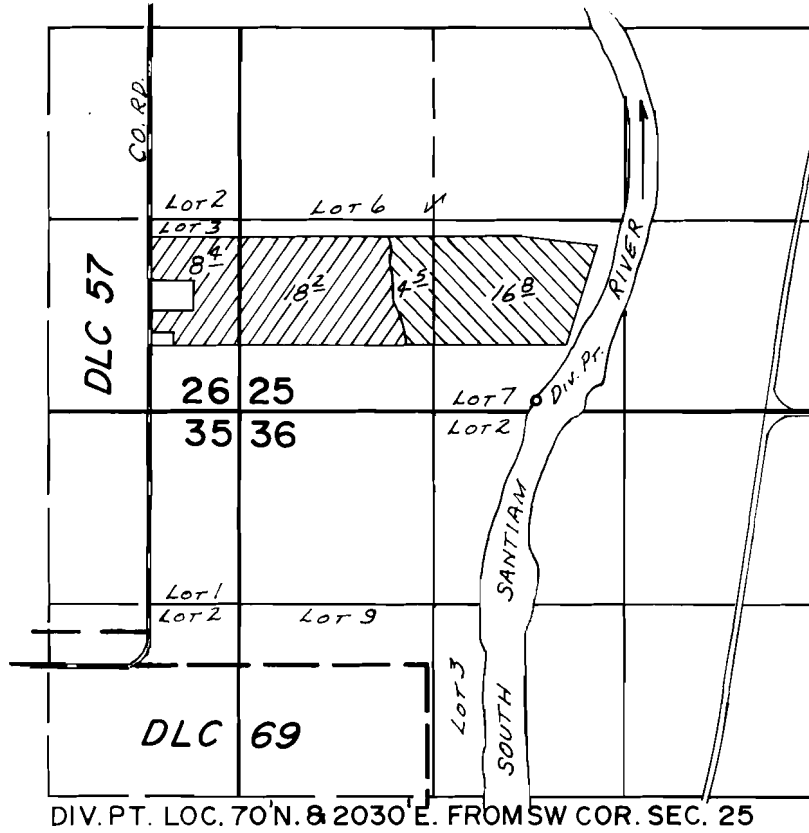

T. 11 S., R. 2 W., W.M.



-  SUPPLEMENTAL
-  PRIMARY

FINAL PROOF SURVEY
UNDER

Application No. 58227... Permit No. 43864.....
IN NAME OF

.....**BOYD H. BEWLEY**.....

Surveyed MAY 26... 1982., by L.M. TOLL.....