



T.33 S., R.2 E., W.M.

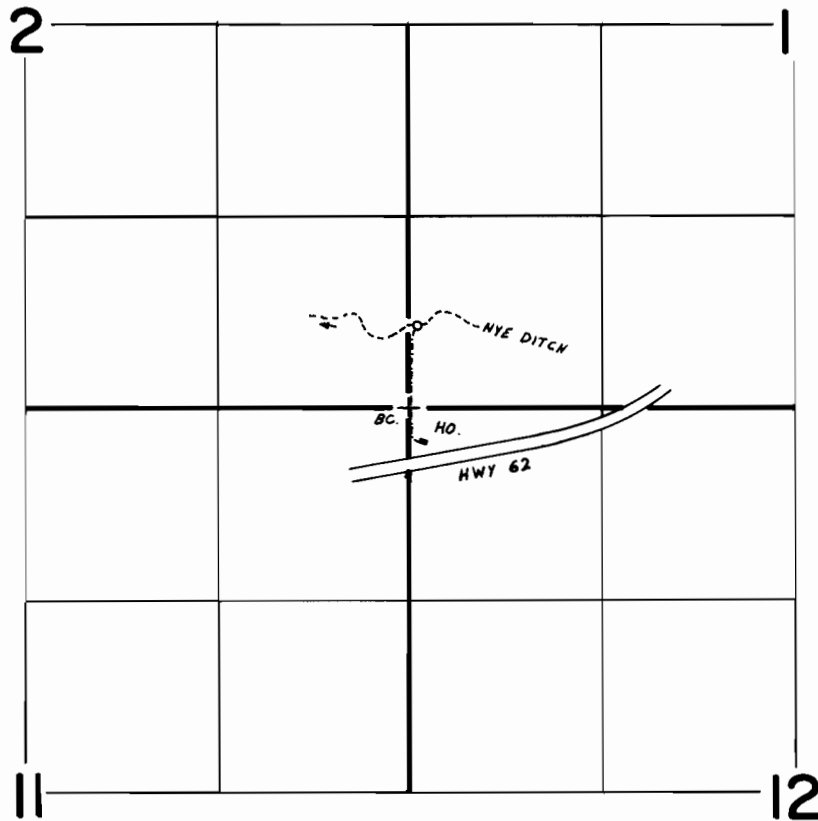

T.32 S., R.3 E., W.M.

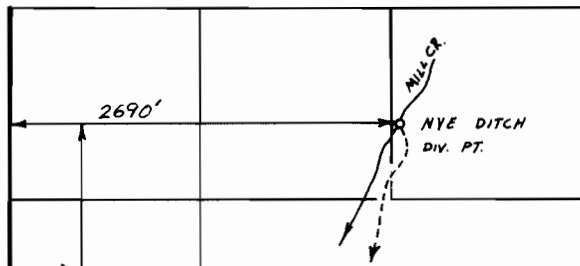

Scale 1" = 1320'

29 28
32 33

FINAL PROOF SURVEY
UNDER

Application No. 58385 Permit No. 43979
IN NAME OF

JOHN STOUT

Surveyed May. 23, 1983, by BS. JAMES