


T. 1S., R. 10W. W.M.

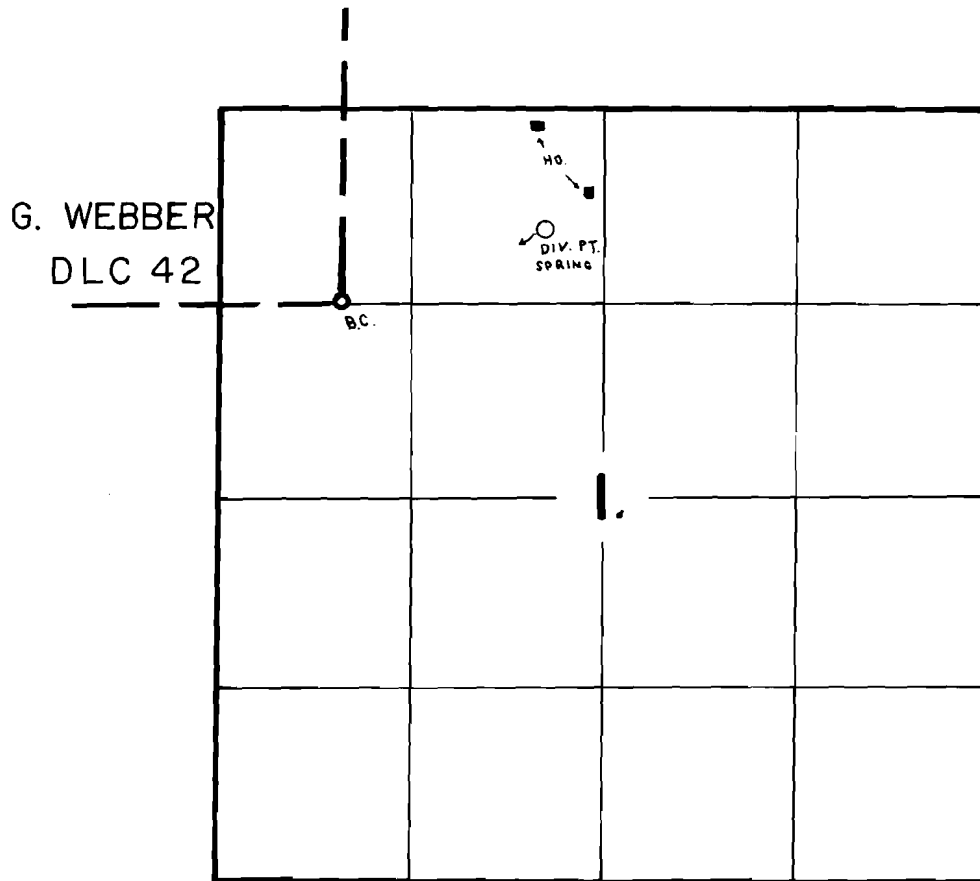

DIV. PT. LOC.: 550' N. & 1350' E. OF SE COR. DLC 42

FINAL PROOF SURVEY
UNDER

Application No. 58405 Permit No. 43993
IN NAME OF

RICHARD C. WRIGHT

Surveyed OCT. 25 1983, by PAGTER, P.