



T. 33 S., R. 2 E., W. M.

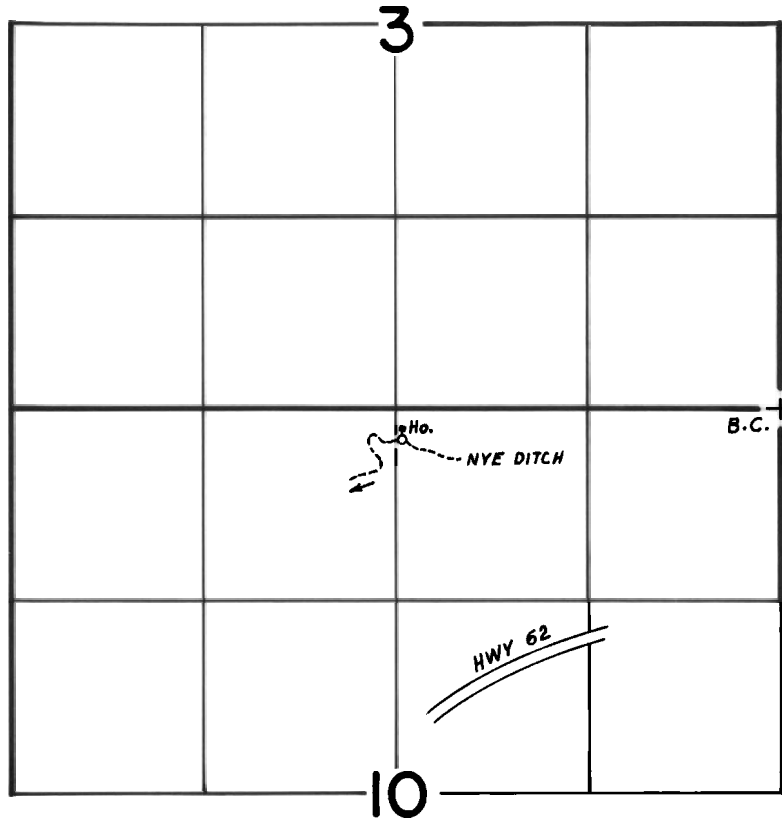

T. 32 S., R. 3 E., W. M.

SCALE: 1" = 1320'

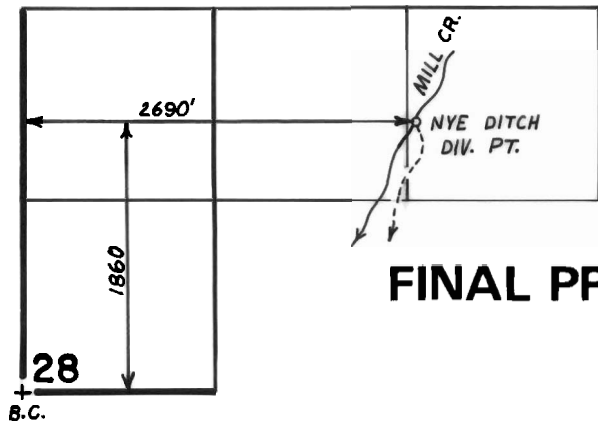

FINAL PROOF SURVEY
UNDER

Application No. 58492 Permit No. 44065
IN NAME OF

GEORGE W. RING, Jr.

Surveyed MAY 25 1983, by B. S. JAMES