



T.33S., R.2E., W.M.

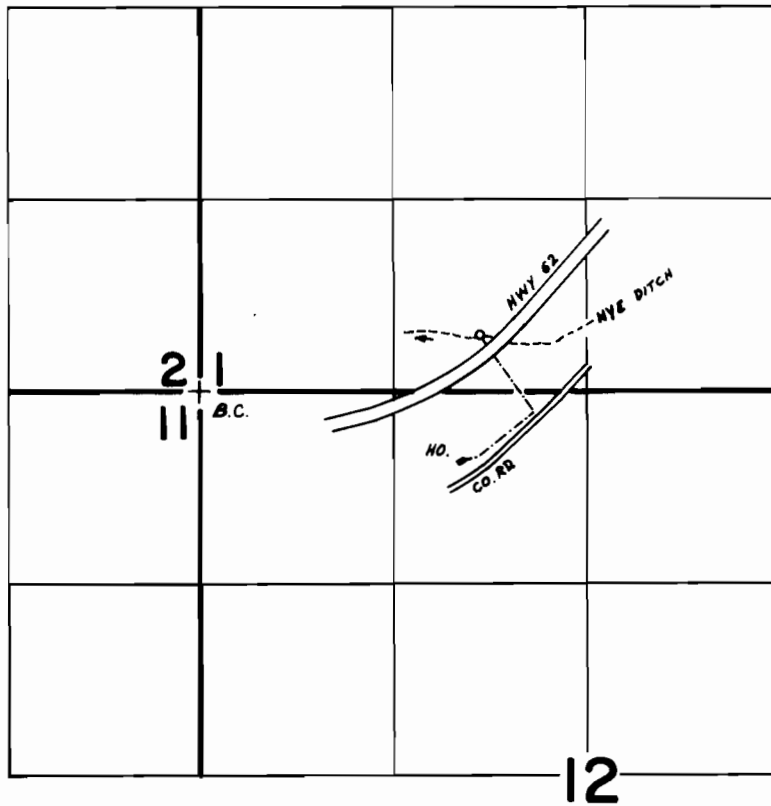

T.32S., R.3E., W.M.

Scale 1" = 1320'

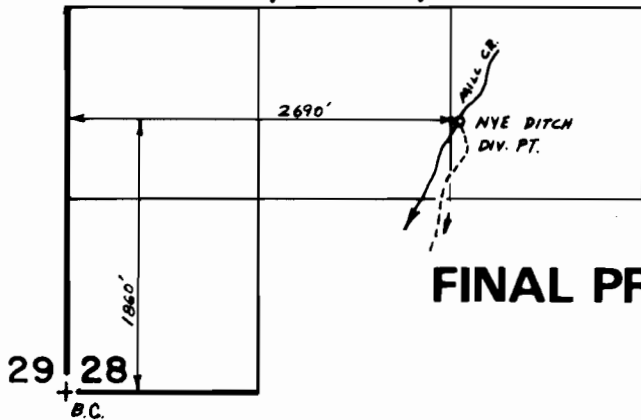

FINAL PROOF SURVEY UNDER

Application No. 58569.. Permit No. 44172.....
IN NAME OF

.....JACK...&...JEAN...RICH.....

Surveyed May..24., 1983., by B.S.JAMES.....