


T.5S.R.10W.W.M.

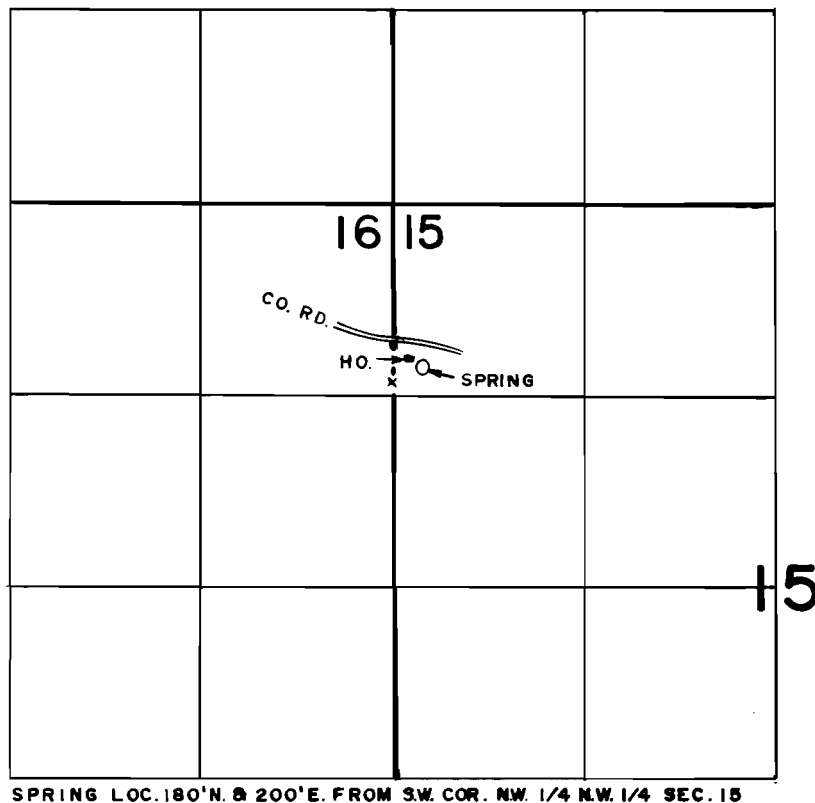

SPRING LOC. 180' N. & 200' E. FROM S.W. COR. NW 1/4 NW 1/4 SEC. 15

FINAL PROOF SURVEY
UNDER

Application No. 58.7.74 Permit No. 44189.....
IN NAME OF

JAMES L. KNOTTS.....

Surveyed JAN 22, 1980, by R.G. MUCKEN.....