


T.5N.R.9W.W.M.

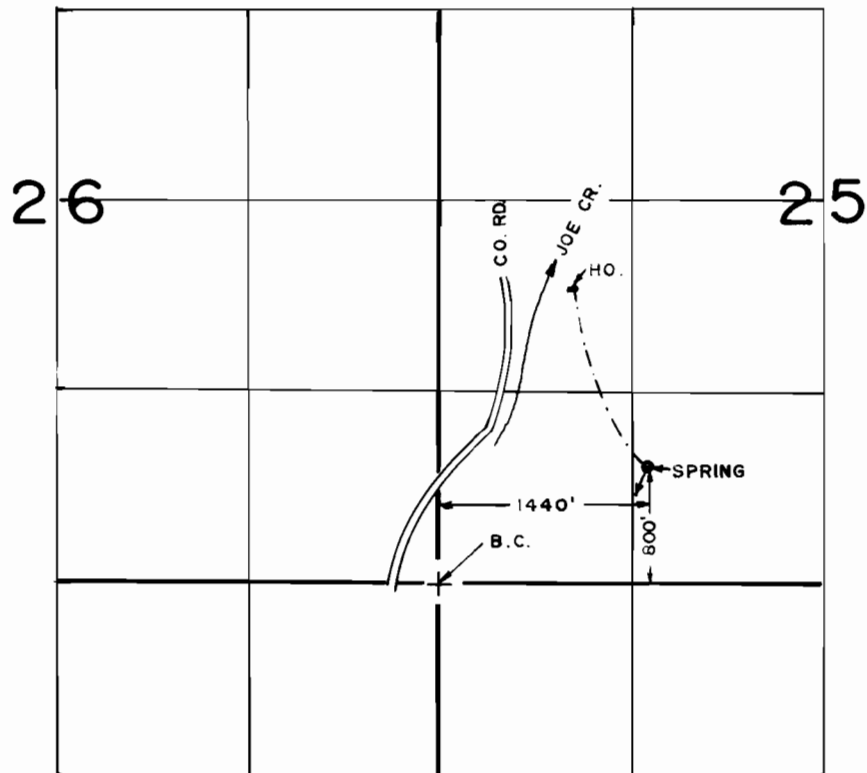

**FINAL PROOF SURVEY**  
UNDER

Application No. 58760 Permit No. 44301.....  
IN NAME OF

THOMAS C. BROWN.....

Surveyed FEB. 20, 1980, by R.G. MUCKEN.....