


T.8S.,R.10W.,W.M.

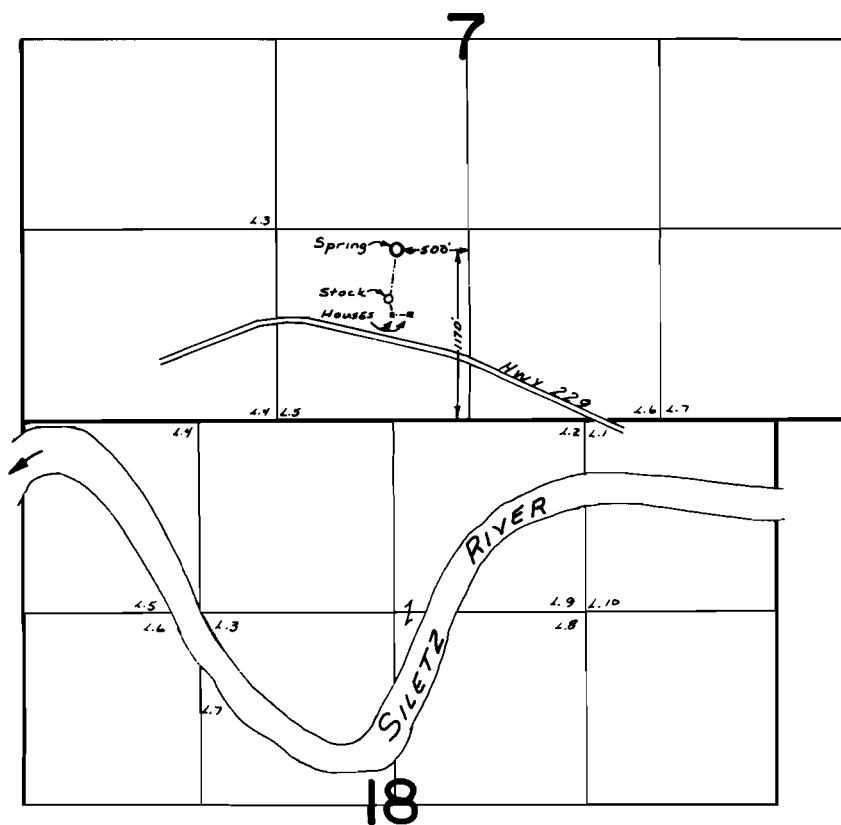

**FINAL PROOF SURVEY**  
UNDER

Application No. 58771.. Permit No. 44341.....  
IN NAME OF

.....BYRON E. HOLMES.....

Surveyed Oct. 22, 1981., by S. C. BROWN.....