



9-3-1

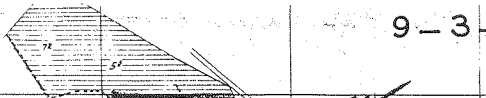


1.5-1940  
 1.7-1942  
 0.6-1890L  
 2-W-1931

30-W-1940  
 12-W-1931

12-W-1940  
 25-W-1931  
 18.9-1880L  
 2.9-1972  
 0.2-1925  
 9-W-1931  
 2-W-1946

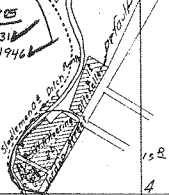

1-1894  
 3-1918

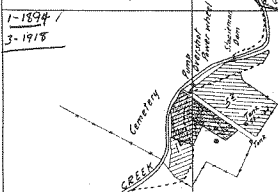

1-1896



7-1863