


T. 32S., R. 6 W., W.M.

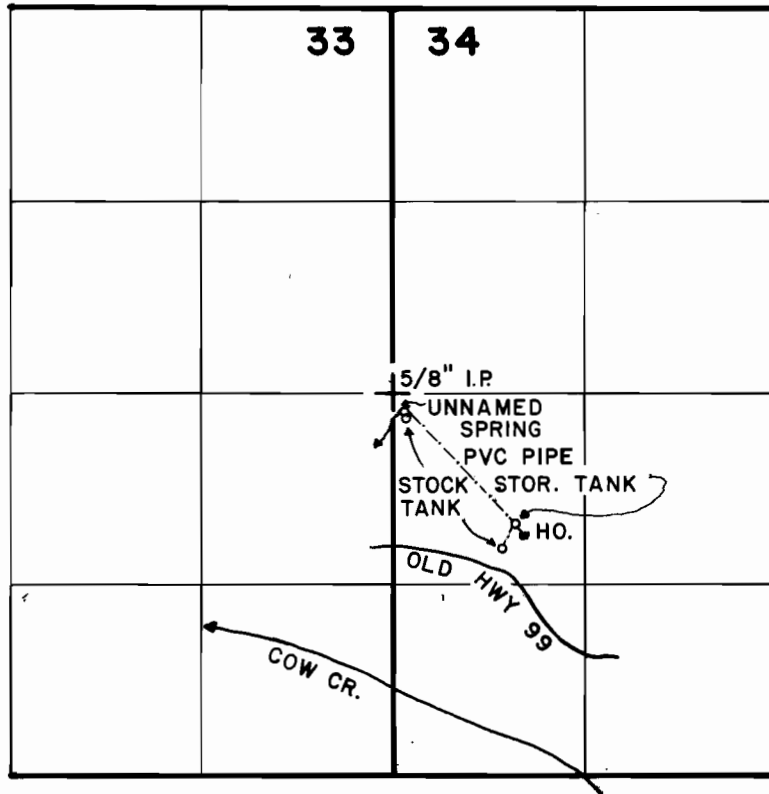

SPRING IS LOCATED 120' S. & 75' E. FROM W. 1/4 COR. SEC. 34.

SCALE: 4" = 1 MILE

FINAL PROOF SURVEY UNDER

Application No. **59225** Permit No. **44545**
IN NAME OF

VERNON W. ORTMAN

Surveyed **AUG. 16**, 19**84**, by **L.E. CASHION**