



T.1S., R.8W., W. M.

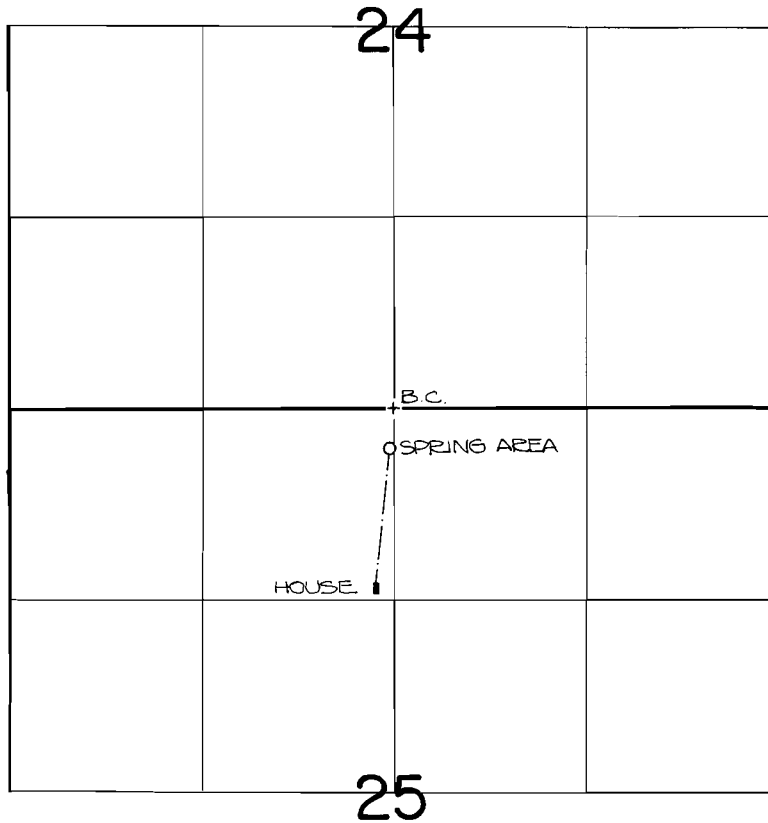

SPRING AREA LOCATION: 260 FT. S. AND 30 FT. W. FROM
THE N. 1/4 CORNER OF SECTION 25.

FINAL PROOF SURVEY
UNDER

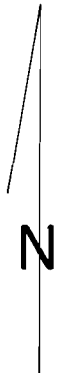

Application No. 59919... Permit No. 44784.....
IN NAME OF

SCALE: 4" = 1 MILE

WAYNE J. & MYRTLE M. WILLIAMS AND KENNETH M. WILLIAMS

Surveyed JUNE 14, 1984, by *P. Patten*