
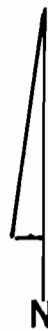


T. 3 S., R. 10 W., W.M.

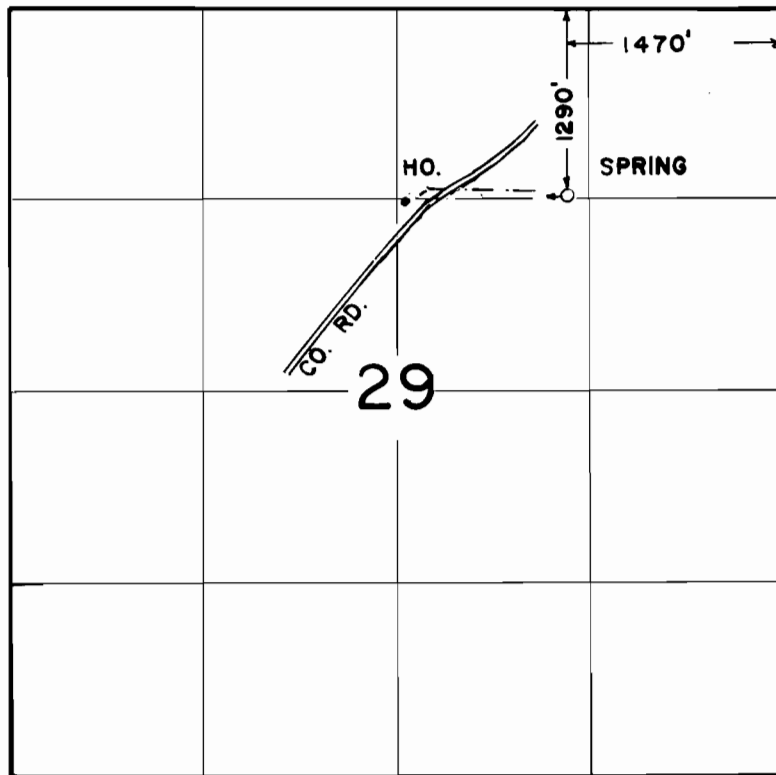

SCALE
1" = 1320'

FINAL PROOF SURVEY
UNDER

Application No. 59300.. Permit No. 44792.....
IN NAME OF

.....LOUIS BARINAGA.....

Surveyed JUL 31 1984, by P. PAGTER.....