


# T.8S.,R.10W.,W.M.

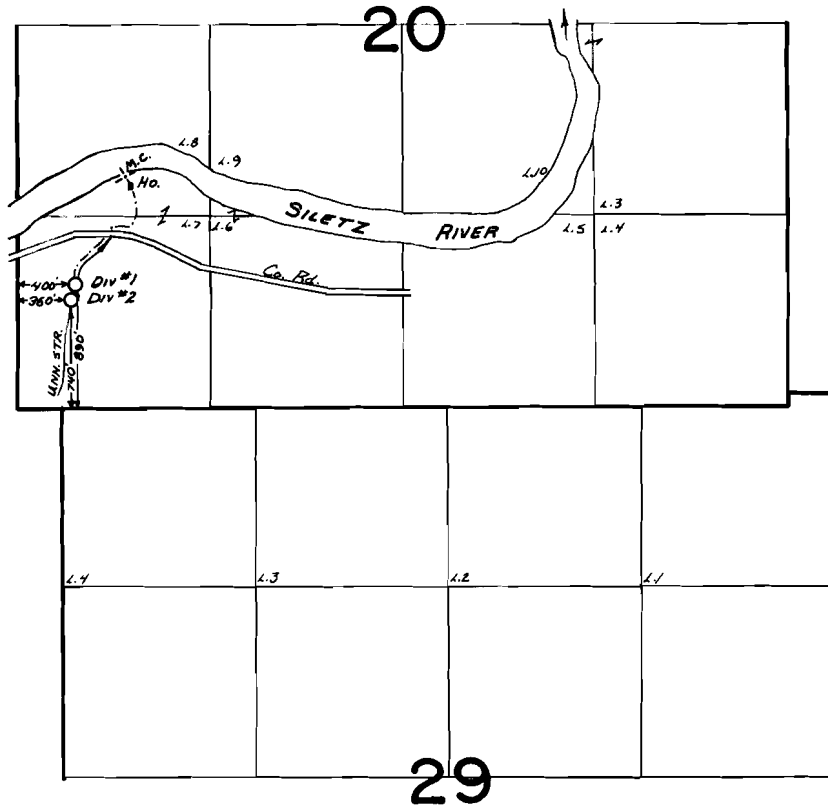

## FINAL PROOF SURVEY UNDER

Application No. 59749 Permit No. 44999.....  
IN NAME OF

.....Errol S. & Marion L. Carpenter.....

Surveyed Oct. 22, 1981., by S.C. BROWN.....