


T. 2 S., R. 9 W., W.M.

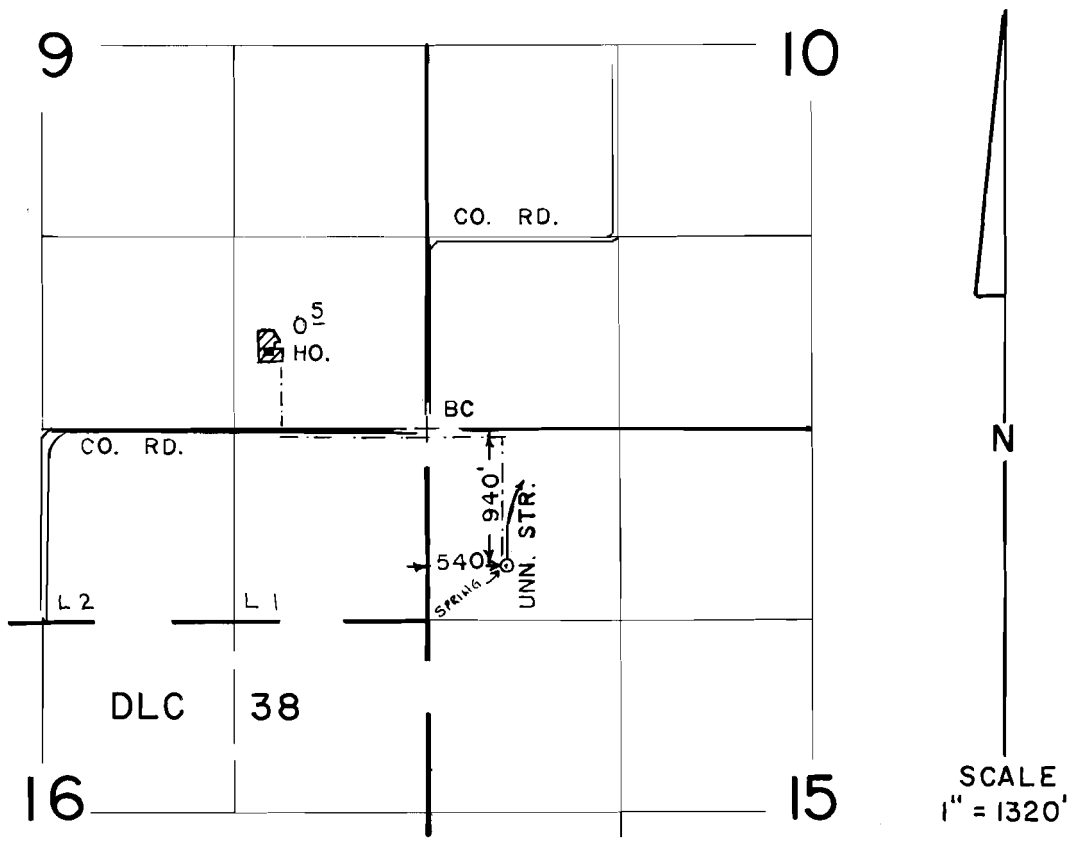

FINAL PROOF SURVEY UNDER

Application No. 59744 Permit No. 45186
IN NAME OF

JOYCE WERNER

Surveyed JUL 30 1984, by P. PAGTER