



T. 3 S. R. 45 E. W.M.

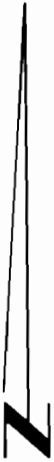

SCALE: 1"=1320'

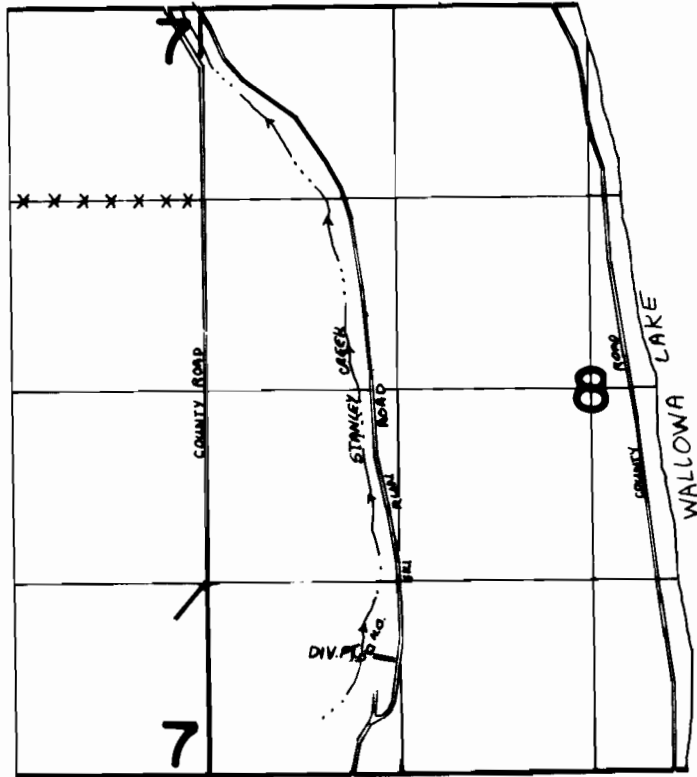

DIV. PT. LOCATED 800' N. AND 1050' E. FROM SW. SEC. COR. SEC. 8

FINAL PROOF SURVEY
UNDER

Application No. 60489.. Permit No. 45211.....
IN NAME OF

.....NILS. K. AMES.....

Surveyed ~~AUGUST~~ 7... 19~~24~~, by V.L. CHURCH.....