


# T. 26 S., R. 4 W., W.M.

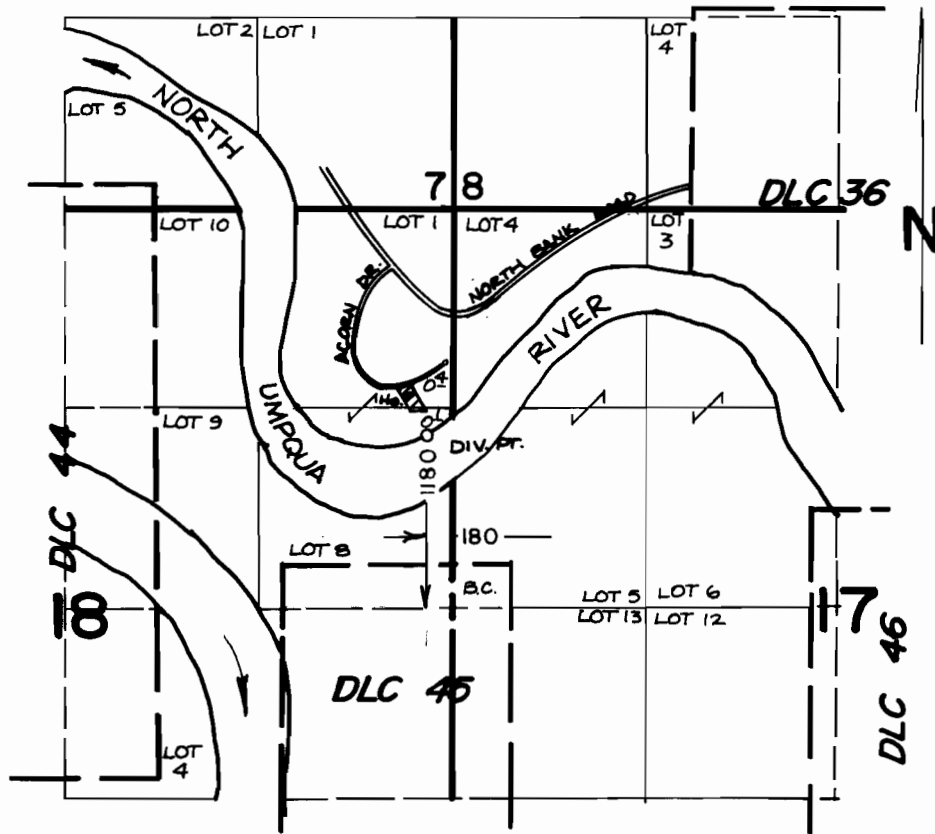

SCALE : 4" = 1 MILE

## FINAL PROOF SURVEY UNDER

Application No. 60432 Permit No. 45251  
IN NAME OF

CARLYLE W. & BARBARA L. MICHAELS

Surveyed SEPT. 9, 1986, by J.R. KAUPPILA