


T. 20 S., R. 5 W., W.M.

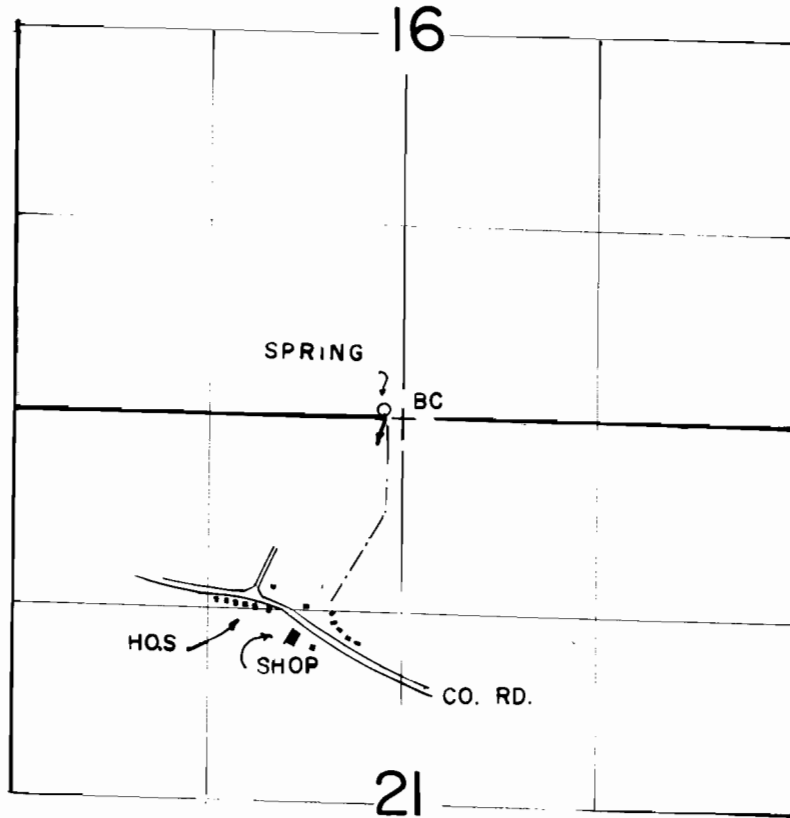

SPRING LOC. 50' N. & 150' W. OF N. 1/4 COR. SEC. 21

FINAL PROOF SURVEY
UNDER

Application No. 59666... Permit No. 45336.....

IN NAME OF

BERTHA M. FITCH.....

Surveyed SEP. 25 1984, by P. PAGTER.....