


P-45518
C-56959

T.13S. R.28E. W.M.

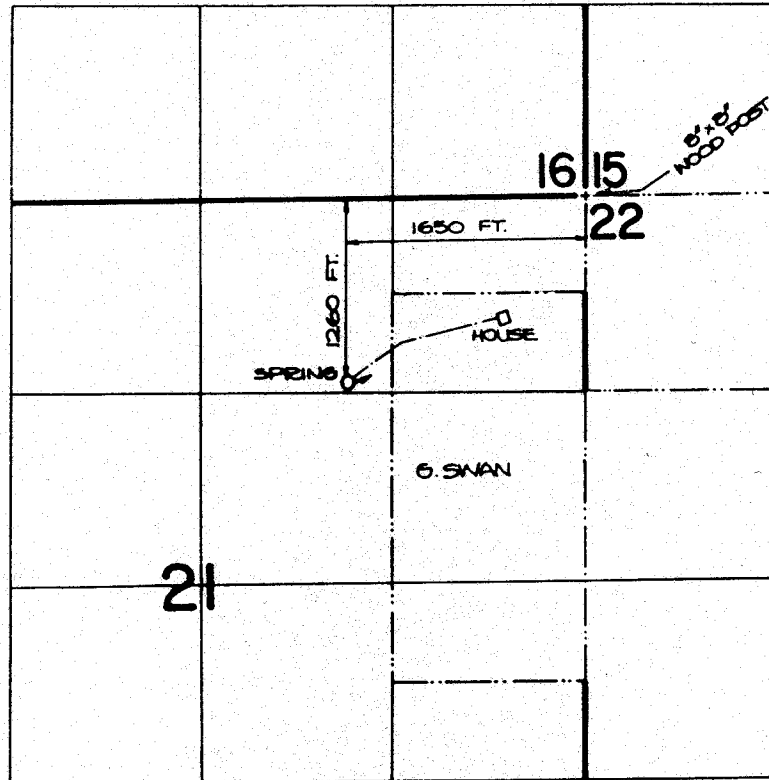

RECEIVED

MAR 30 1988

WM. DIST. 14
GRANTS PASS, ORE.

SCALE: 4" = 1 MILE

FINAL PROOF SURVEY
UNDER

Application No. 59861.. Permit No. 45518.....
IN NAME OF

GEORGE SWAN

Surveyed AUG. 8, 1984, by P. P. Pagan