


T. 33S., R. 6W, W.M.

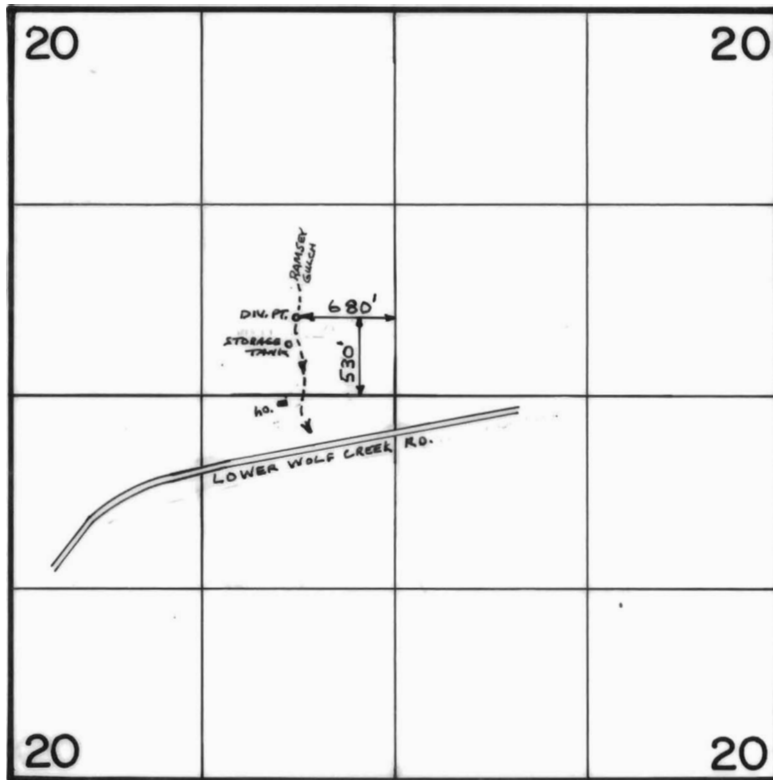

SCALE 1" = 1320"

**FINAL PROOF SURVEY**  
UNDER

Application No. 61065..... Permit No. 45625.....  
IN NAME OF

GEORGE & MARION E. BOWEN.....

Surveyed SEPT. 5... 1984.. by J.R. WOODROOF..