


T.17S.,R.6W.,W.M.

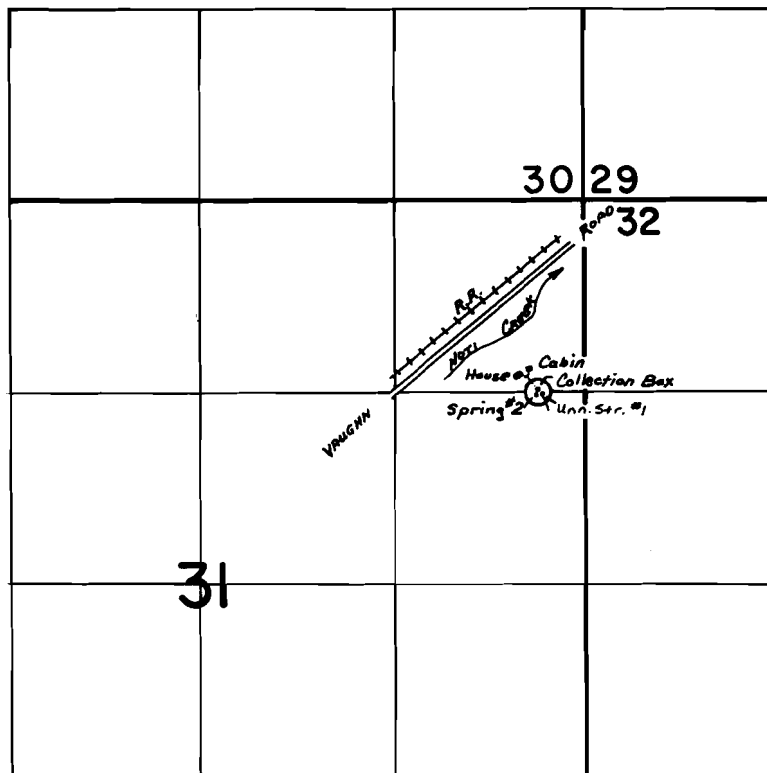

Stream Loc: 1340 ft S and 290 ft W } from the NE Cor. Sec. 31
 Spring Loc: 1350 ft S and 340 ft W }

FINAL PROOF SURVEY UNDER

Application No. 54667 41016
 61550 Permit No. 45688

IN NAME OF

VINCENT J. 8
 SHIRLEY M. CLARIC

Surveyed May 5, 1982, by L. M. TOLL